

**SURVEY &
REMONUMENTATION**

APR 27 1995

REMONUMENTATION CORNER

98552

COMMISSION

LAND CORNER RECORDATION CERTIFICATE

Filing Requirement of Act 74, Mich. P.A. 1970

For corners in

<u>ISABELLA</u> (County)	Located In:	Corner Code #
1. Public Land Survey	T <u>14N</u> R <u>4W</u>	<u>M-8</u>
	T _____ R _____	_____
	T _____ R _____	_____
	T _____ R _____	_____
2. Property Controlling in Section	S _____ T _____ R _____	_____
	S _____ T _____ R _____	_____
3. Miscellaneous Property in Sec.	S _____ T _____ R _____	_____
	S _____ T _____ R _____	_____
4. Lot No. _____, Recorded Plat _____		
5. Private Claims _____		

STATE OF MICHIGAN
COUNTY OF ISABELLA
REGISTER OF DEEDS

MAR 13 2 21 PM '95
000060
SHARON A. BROWN
REGISTER OF DEEDS

Register of Deeds Stamp & File Number


I, Wm. B. Ruddell in a field survey on December 19 95, do hereby certify that under requirements of P.A. 74, Michigan P.A. of 1970, the corner points mentioned in lines 1 and 2 above were in conformance with regulations and rules therefore as required in the current manual of survey instructions of the United States Department of the Interior, Bureau of Land Management or by a decree of a Court of Law and/or that the corner points mentioned in lines 3, 4 and 5 above were in conformance with the rules of the Michigan Board of Land Surveyors or by a Decree of a Court of Law; established, re-established, monumented, re-monumented, recovered, found as expressed below:

NOTE: Not more than 4 corners, all in the same town and range, may be recorded on this certificate.

A	B	C	D	E	F	G	H	I	J	K	L	M
2	6	5	4	3	2	1						
3												
4	7	8	9	10	11	12						
5												
6	18	17	16	15	14	13						
7												
8	19	20	21	22	23	24						
9												
10	30	29	28	27	26	25						
11												
12	31	32	33	34	35	36						
13												

A. Description of original monument and accessories and/or subsequent restoration:

- 1937 - Set Post
- 1838 - Found Post
- 1972 - Found 1"x1" square rod
- 1989 - Found 1"x1" square rod
- 1994 - Found 3/4" pipe in monument box

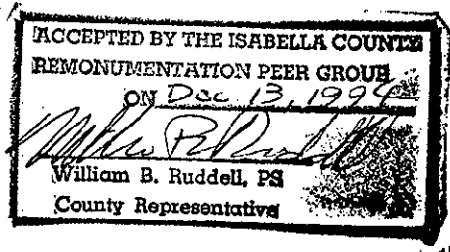

B. Description of corner evidence found and/or method applied in restoring or reestablishing corner:


- 1994 - Fnd: 3/4" pipe in monument box - witnessed & removed augered to Depth of 4' ± - Found no other evidence
Corner verified from witnesses of 1989 - LCRC - 978

This corner not established by original Government Surveyors. This monument is accepted as the best available evidence of the position of the corner.

C. Description of monument for corner and accessories established to perpetuate locating the position of the corner:

March 1995, Set standard monument in existing monument box.

Witnesses: N, 60.65', Jog corner 2" Pipe in mon. box
NE, 71.03', PK in 15" CMP 0.5' fr S. end
SSW, 149.60', N&C in Power Pole
W, 57.6', N&C in 5" Basswood

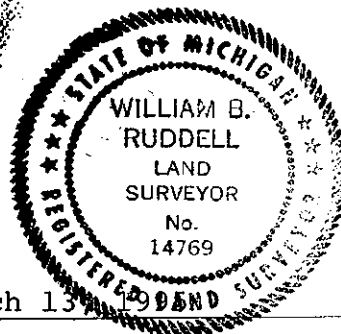

Signed by William B. Ruddell
Surveyor's Michigan License No. 14769

Date March 13, 1995