

JAN 19 2001

00016

ISABELLA COUNTY REMONUMENTATION PROGRAM  
LAND CORNER RECORDATION CERTIFICATE  
Filing Requirement of Act 74, Mich. P.A. 1970

SECTION

For corners in  
Isabella  
(County)

	Located in:	Corner Code #
1. Public Land Survey	T <u>14N</u> R <u>4W</u>	<u>L-5</u>
	T ___ R ___	_____
	T ___ R ___	_____
	T ___ R ___	_____
2. Property Controlling in Section	S ___ T ___ R ___	_____
	S ___ T ___ R ___	_____
3. Miscellaneous Property in Sec.	S ___ T ___ R ___	_____
	S ___ T ___ R ___	_____
4. Lot No. _____, Recorded Plat _____		
5. Private Claims _____		

200100000016  
Filed for Record in  
ISABELLA COUNTY, MI  
SHARON A BROWN  
01-02-2001 10:55:11 am.  
RE LAND COR 9.00  
Liber 2 Page 50 - 50

50

Register of Deeds Stamp & File Number

I, RODNEY CLAYPOOL, in a field survey on June 28, 1999, do hereby certify that under requirements of P.A. 74, Michigan P.A. of 1970, the corner points mentioned on lines 1 and 2 above were in conformance with regulations and rules therefore as required in the current manual of survey instructions of the United States Department of the Interior, Bureau of Land Management or by a decree of a Court of Law and/or that the corner points mentioned in lines 3, 4 and 5 above were in conformance with the rules of the Michigan Board of Land Surveyors or by a Decree of a Court of Law; re-established, monumented, re-monumented, recovered, found as expressed below:

NOTE: Not more than 2 corners, all in the same town and range, may be recorded on this certificate.

A	B	C	D	E	F	G	H	I	J	K	L	M
2	6	5	4	3	2	1						
3												
4	7	8	9	10	11	12						
5												
6	18	17	16	15	14	13						
7												
8	19	20	21	22	23	24						
9												
10	30	29	28	27	26	25						
11												
12	31	32	33	34	35	36						
13												

A. Description of original monument and accessories and/or subsequent restoration:

L-5 1/4 Corner common to Sections 12 and 13  
Remonumentation LCRC (Page 022) by N. Caldwell, 1993, found bolt in monument box

B. Description of corner evidence found and/or method applied in restoring or reestablishing corner:


L-5 1/4 Corner common to Sections 12 and 13  
Found RR bolt in monument box at position per Remon LCRC by N. Caldwell.

NOTE: This corner as done by Caldwell and accepted for remonumentation was removed under the MDOT contract for reconstruction of M-20 and not properly documented for replacement. Therefore additional review was necessary to verify that the corner was at the accepted location.

C. Description of monument for corner and accessories established to perpetuate locating the position of the corner:

L-5 1/4 Corner common to Sections 12 and 13  
Set standard Isabella Co. Remonumentation rod and cap stamped Isabella County Remonumentation Corner Code L-5 PS 29241 in monument box over RR iron.

- N 15 Deg W, 38.52', nail and disc in guard post (Rec. 38.45')
- N 62 Deg W, 81.61', SE corner bridge pier (Rec. 81.67)
- S 62 Deg W, 78.68', NE corner bridge pier (Rec. 78.81)
- S 9 Deg W, 54.19', nail and disc in power pole (Rec. 54.19')
- N 32 Deg W, 46.36', chiseled "+" in NE bolt on light pole base
- N 48 Deg W, 73.40', chiseled "+" in SE'ly corner retaining wall
- N 47 Deg W, 71.76', chiseled "+" in NE'ly corner retaining wall

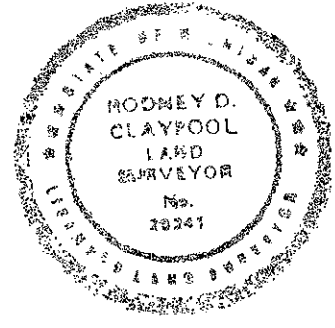

Signed by Rodney D. Claypool  
Surveyor's Michigan License No. 29241

Date 12-26-00  
Form approved by Michigan State Board of Land Surveyors, Jan. 28, 1971  
Revised May 14, 1971  
Revised Jan., 1983

