

125312

LAND CORNER RECORDATION CERTIFICATE
Filing Requirement of Act 74, Mich. P.A. 1970
Isabella County Remonumentation

000172

SURVEY &
REMONUMENTATION

For Corners in
Isabella

(County)

Located In:

Corner Code#:

- 1. Public Land Survey T. 14N R. 5W H-5
2. Public Controlling in Section S. T. R.
3. Miscellaneous Property in Section S. T. R.
4. Lot No. Recorded Plat
5. Private Claims

9700125312
Filed for Record in
ISABELLA COUNTY, MI
SHARON A BROWN
On 10-30-1997 At 08:39:49 am.
RE LAND COR 9.00
Book OR Vol. 1 Pg. 172 - 172

NOV 07 1997

COMMISSION

Register of Deeds Stamp & File Number


I, Jan S. Fokens, in a field survey on July 7, 1997, do hereby certify that under requirements of P.A. 74, Michigan P.A. of 1970, the corner points mentioned in lines 1 and 2 above were in conformance with regulations and rules therefore as required in the current manual of survey instructions of the United States Department of the Interior, Bureau of Land Management or by a decree of a Court of Law and/or that the corner points mentioned in lines 3, 4 and 5 above were in conformance with the rules of the Michigan Board of Land Surveyors or by a Decree of a Court of Law, established, re-established, monumented, re-monumented, recovered, found as expressed below.

NOTE: Not more than 2 corners, all in the same town and range, may be recorded on this certificate.


Grid table with columns A-M and rows 1-13. Contains numbers 1-36 and a diamond symbol in row 5, column I.

A. Description of original monument and accessories and/or subsequent restoration:

- 1. G.L.O Original Survey
Township Lines: 2nd Quarter 1837 John Hodgson
Subdivision and Resurveying: 4th Quarter 1838 R. Witcomb
Page 426 Original Field Notes
2. County Survey Records:
Liber 2 Page 263 Dated April 10-11, 1884 J.A. Graham
Liber 2 Page 262-3 Dated April 10-11 1884 J.A. Graham
Liber 3 Page 58 Dated May 1895 H.N. Rose
3. L.C.R.C.
Liber 1 Page 136 A.V. Courtright Recorded date December 29, 1972
Liber 2 Page 593 William Ruddell Recorded date January 30, 1980
4. Surveys of Record
Liber 2 Page 510 Found T-iron in 3" pipe
Liber 3 Page 169 Found T-iron
Liber 3 Page 375 Found T-iron
Liber 4 Page 300 Found T-iron in 3" pipe
Liber 5 Page 127
5. Unrecorded Survey
I.C.R.C. alignment notes Found T-iron witnesses noted
R.E.I. files Found T-iron witnesses noted
L.S.C. field notes Section subdivision

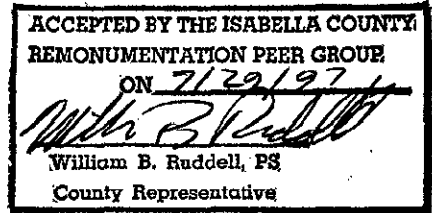

Found T-iron in 3" pipe
Found T-iron

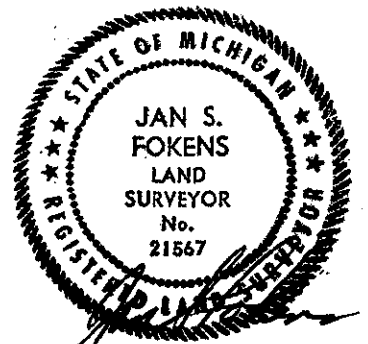

B. Description of corner evidence found and/or method applied in restoring or re-establishing corner:

- This corner established in Isabella County Remonumentation Program. See dossier for detailed report.
1. Found 1/2" iron rod in monument box at road surface
2. Found T-iron 1.68' below road surface
3. Found 3" pipe 2.0' below road surface
4. Found decayed wood at 2.5' below road surface
5. Drilled through 3" pipe to find decayed wood
6. Stopped excavating at 3.0'. Found no further evidence

Accepted as best available evidence of the perpetuation of 1884 J.A. Graham survey and replaced with Standard Monument Corner. H-5 was approved for remonumentation at a Peer Review Committee meeting on July 29, 1997.

C. Description of monument for corner and accessories established to perpetuate locating the position of the corner:

- Set Standard Isabella County Monument in Monument Box.
N39°W 44.45' Set nail & LSC tag in 4" diameter wood fence post
N14°E 31.00' Set nail & LSC tag in 4" diameter wood fence post
S48°E 64.46' Set nail & LSC tag in 4" diameter wood fence post
Due South 33.55' Top center steel fence post

Signed by [Signature]
Surveyor's Michigan License No. 21567

Date 10/23/99