

125315

LAND CORNER RECORDATION CERTIFICATE
Filing Requirement of Act 74, Mich. P.A. 1970
Isabella County Remonumentation

NOV 07 1997

COMMISSION

For Corners in
Isabella
(County)

000175

	Located In:	Corner Code#:
1. Public Land Survey	T. <u>14N</u> R. <u>5W</u>	<u>I-5</u>
	T. _____ R. _____	_____
	T. _____ R. _____	_____
2. Public Controlling in Section	S. _____ T. _____ R. _____	_____
	S. _____ T. _____ R. _____	_____
3. Miscellaneous Property in Section	S. _____ T. _____ R. _____	_____
	S. _____ T. _____ R. _____	_____
4. Lot No. _____, Recorded Plat _____		
5. Private Claims _____		

9700125315
Filed for Record in
ISABELLA COUNTY, MI
SHARON A BROWN
On 10-30-1997 At 08:40:08 am.
RE LAND COR 9.00
Book OR Vol. 1 Pg. 175 - 175

Register of Deeds Stamp & File Number


I, Jan S. Fokens, in a field survey on July 7, 1997, do hereby certify that under requirements of P.A. 74, Michigan P.A. of 1970, the corner points mentioned in lines 1 and 2 above were in conformance with regulations and rules therefore as required in the current manual of survey instructions of the United States Department of the Interior, Bureau of Land Management or by a decree of a Court of Law and/or that the corner points mentioned in lines 3, 4 and 5 above were in conformance with the rules of the Michigan Board of Land Surveyors or by a Decree of a Court of Law, established, re-established, monumented, re-monumented, recovered, found as expressed below.

	A	B	C	D	E	F	G	H	I	J	K	L	M
1													
2	6	5	4	3	2	1							
3													
4	7	8	9	10	11	12							
5													
6	18	17	16	15	14	13							
7													
8	19	20	21	22	23	24							
9													
10	30	29	28	27	26	25							
11													
12	31	32	33	34	35	36							
13													

NOTE: Not more than 2 corners, all in the same town and range, may be recorded on this certificate.

A. Description of original monument and accessories and/or subsequent restoration:


- G.L.O Original Survey
Township Lines: 2nd Quarter 1837 John Hodgson
Subdivision and Resurveying: 4th Quarter 1838 R. Witcomb
Page 418 Original Field Notes
- County Survey Records:
Liber 2 Page 170-1 Dated February 14-17, 1882 J.A. Graham
Liber 2 Page 263 Dated April 10-11, 1884 J.A. Graham
Liber 2 Page 309 Dated September 21-3, 1886 J.A. Graham
Liber 3 Page 58 Dated May 21-25, 1894 H.N. Rose
- L.C.R.C.
Liber 1 Page 136 A.V. Courtright Recorded date December 29, 1972
Liber 4 Page 1273 Gerald Gray Recorded date January 25, 1995
- Surveys of Record
Liber 2 Page 510 Found 2" iron
Liber 3 Page 335 Found 2" axle shaft 1.4' deep
Liber 4 Page 163 Found 5/8" iron with cap
Liber 4 Page 300 Found 2" iron

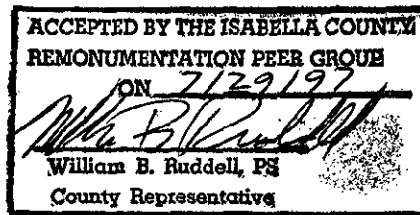

Found 2" iron
Found 1 1/4" pipe in mon. box

- Unrecorded Survey
I.C.R.C. Section corner map Found 2" wheel hub & T-iron witnesses noted
R.E.I. files Found 2" iron witnesses noted
L.S.C. field notes Section subdivision
I.C.R.C. alignment notes Found R.L.S. capped iron witnesses noted

- Description of corner evidence found and/or method applied in restoring or re-establishing corner:
This corner established in Isabella County Remonumentation Program. See dossier for detailed report.
 - Found 2" pipe in monument box at road surface
 - Found 3/4" solid rod .63' below road surface
 - Found R.R. spike in large stone 2' below the road surface. Could not excavate.
 - Stopped excavating at 2.0'. Found no further evidence.

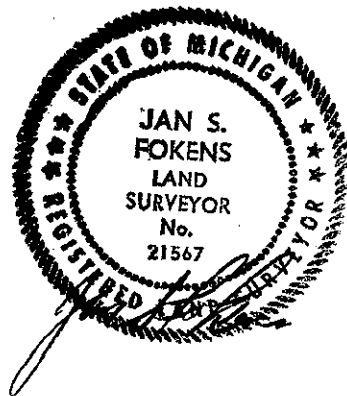

Accepted as best available evidence of the position of the original corner and replaced with Standard Monument Corner. I-5 was approved for remonumentation at a Peer Review Committee meeting on July 29, 1997.

- Description of monument for corner and accessories established to perpetuate locating the position of the corner:
Set Standard Isabella County Monument in Monument Box.
S20°E 69.69' Found nail & tag #17741 in drop pole
S68°W 65.34' Found nail & tag #17741 in N.W. face of telephone pole
N36°W 52.85' Top center of telephone riser
N60°E 48.10' Gas line marker

signed by Jan S. Fokens
Surveyor's Michigan License No. 21567

Date 10/23/97