

00073

SURVEY & REMONUMENTATION

LAND CORNER RECORDATION CERTIFICATE
Filing Requirement of Act 74, Mich. P.A. 1970
Isabella County Remonumentation

MAR 09 1999

SECTION

For Corners in Isabella

Table with columns: (County), Located In: (Township, Range), Corner Code#. Rows include Public Land Survey, Public Controlling in Section, Miscellaneous Property in Section, Lot No., and Private Claims.

9900000073
Filed for Record in ISABELLA COUNTY, MI
SHARON A BROWN
On 01-05-1999 At 09:26:46 am.
RE LAND COR 9.00
Liber 1 Page 262 - 262

Register of Deeds Stamp & File Number


I, Jan S. Fokens, in a field survey on December 1, 1998, do hereby certify that under requirements of P.A. 74, Michigan P.A. of 1970, the corner points mentioned in lines 1 and 2 above were in conformance with regulations and rules therefore as required in the current manual of survey instructions of the United States Department of the Interior, Bureau of Land Management or by a decree of a Court of Law and/or that the corner points mentioned in lines 3, 4 and 5 above were in conformance with the rules of the Michigan Board of Land Surveyors or by a Decree of a Court of Law, established, re-established, monumented, re-monumented, recovered, found as expressed below.

NOTE: Not more than 2 corners, all in the same town and range, may be recorded on this certificate.

Grid table with columns A-M and rows 1-13. Contains numerical data for survey points.

A. Description of original monument and accessories and/or subsequent restoration:

- 1. G.L.O Original Survey
Township Lines: 2nd quarter 1837 John Hodgson
Subdivision: 4th Quarter 1838 R. Whitcomb
Page 444 Original Field Notes
2. County Survey of Record
Liber 3, Page 1 August 1890 E.R. Coburn
3. L.C.R.C.
Liber 1, Page 216 June 7, 1974 William Ruddell Found 1" pipe
4. Survey of Record
Liber 1, Page 42
5. Unrecorded Surveys
Mid-Michigan Engineering August 9, 1993
Land Surveying Consultants November 16, 1993

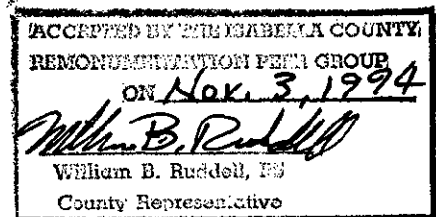

Witness Note: Witnesses from above surveys and LCRC's are available in dossier file; which was presented to peer review committee and is on file at the Register of Deeds Office.

B. Description of corner evidence found and/or method applied in restoring or re-establishing corner:


This corner established in Isabella County Remonumentation Program in 1994. See dossier for detailed report. Corner was disturbed due to road construction. Corner replaced using dossier from original approved corner. See recorded L.C.R.C., Liber 1, Page 45.

C. Description of monument for corner and accessories established to perpetuate locating the position of the corner:
Set Standard Isabella County Monument in Monument Box stamped C-6 and P.S. 21567.

- C-6 E. 1/4 Corner, Section 18, T.14N.-R.5W., Deerfield Township, Isabella County
N.30 °W. 44.07' Double headed nail in power pole
S.50 °W. 70.81' Double headed nail in power pole
S.45 °E. 70.07' Double headed nail in power pole
East 49.55' Double headed nail in N. face of 12" triple Cherry tree
South 2666.12' C-7, SE. Corner, Section 18, T.14N.-R.5W., Deerfield Township, Isabella County

Signed by [Signature]
Surveyor's Michigan License No. 21567

Date DEC. 30, 1998

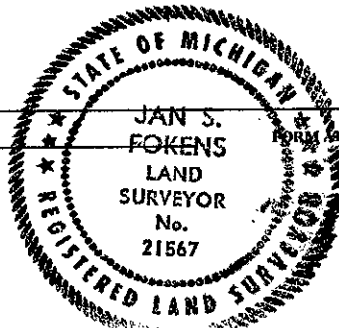

FORM APPROVED BY MICHIGAN STATE BOARD OF LAND SURVEYORS, JAN. 28, 1971
REVISED MAY 14, 1975
REVISED JAN., 1983