

**SURVEY &  
REMONUMENTATION**

MAR 09 1998

SECTION

**REMONUMENTATION CORNER**

**LAND CORNER RECORDATION CERTIFICATE**

Filing Requirement of Act 74, Mich. P.A. 1970

For corners in

Isabella  
(County)

Located in:

Corner Code #

9700125612  
Filed for Record in  
ISABELLA COUNTY, MI  
SHARON A BROWN  
On 11-07-1997 At 08:56:07 am.  
RE LAND COR 9.00  
Book OR Vol. 1 Pg. 187 - 187

Register of Deeds Stamp & File Number

- |                                    |   |            |   |           |            |
|------------------------------------|---|------------|---|-----------|------------|
| 1. Public Land Survey              | T | <u>14N</u> | R | <u>6W</u> | <u>A-8</u> |
|                                    | T |            | R |           |            |
|                                    | T |            | R |           |            |
|                                    | T |            | R |           |            |
| 2. Property Controlling in Section | S |            | T | R         |            |
|                                    | S |            | T | R         |            |
| 3. Miscellaneous Property in Sec.  | S |            | T | R         |            |
|                                    | S |            | T | R         |            |

4. Lot No. \_\_\_\_\_, Recorded Plat \_\_\_\_\_  
5. Private Claims \_\_\_\_\_

I, Ronald R. Harris, in a field survey on March 26, 19 97, do hereby certify that under requirements of P.A. 74, Michigan P.A. of 1970, the corner points mentioned in lines 1 and 2 above were in conformance with regulations and rules therefore as required in the current manual of survey instructions of the United States Department of the Interior, Bureau of Land Management or by a decree of a Court of Law and/or that the corner points mentioned in lines 3, 4 and 5 above were in conformance with the rules of the Michigan Board of Land Surveyors or by a Decree of a Court of Law; established, re-established, monumented, re-monumented, recovered, found as expressed below:

**NOTE: Not more than 2 corners, all in the same town and range, may be recorded on this certificate.**


**A. Description of original monument and accessories and/or subsequent restoration:**

- 1837 Post by John Hodson in Survey of Sec 24, T14N-R7W
- 1904 Coburn set stake at equi-distance (B.4, P.20)
- 1968-72 MSHD Job No. 00519A Fnd. 6" stone, raised with 5/8" rerod
- 1994 Gray LCRC 1264 Fnd. 1/2" rod in Mon. Box

**B. Description of corner evidence found and/or method applied in restoring or reestablishing corner:**

March 1997 Found 5/8" iron rod in Mon. Box  
Excavated to depth of 3.5 feet, hit stone of undetermined size  
Found no further evidence or monumentation  
Measurements:  
A-8 to A-7 = 2637.59' (2637.53' MSHD)  
A-8 to A-9 = 2634.86'  
Corner on line A-7 to A-9

Accepted as the best available evidence for the position of the accepted corner. Corner was approved by the Peer Review Committee on:

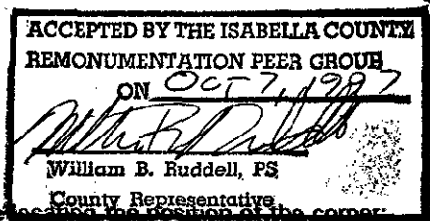

**C. Description of monument for corner and accessories established to perpetuate the position of the corner:**

A standard remonumentation corner was set/stamped with corner's code number (A-8) and P.S. 41917.

WITNESSES:

- West 35.80' Fnd. nail and tag in 4"x4" corner post
- SE 39.15' Fnd. nail and tag in railroad tie corner post
- East 36.35' Fnd. nail and tag in 4"x4" post
- NW 50.65' Set nail and tag in 8" White Pine

Signed by R.R.H. Date 10/30/97  
Surveyor's Michigan License No. 41917

