

**SURVEY &
REMONUMENTATION**

MAR 09 1998

**REMONUMENTATION CORNER
LAND CORNER RECORDATION CERTIFICATE
Filing Requirement of Act 74, Mich. P.A. 1970**

SECTION

For corners in

Isabella
(County)

Located In:

Corner Code #

9700125613
Filed for Record in
ISABELLA COUNTY, MI
SHARON A BROWN
On 11-07-1997 At 08:56:12 am.
RE LAND COR 9.00
Book OR Vol. 1 Pg. 188 - 188

1. Public Land Survey	T	14N	R	6W	B-7
	T		R		
	T		R		
	T		R		
2. Property Controlling in Section	S	T	R		
	S	T	R		
3. Miscellaneous Property in Sec.	S	T	R		
	S	T	R		

Register of Deeds Stamp & File Number

4. Lot No. _____, Recorded Plat _____
5. Private Claims _____

	A	B	C	D	E	F	G	H	I	J	K	L	M
1													
2	6	5	4	3	2	1							
3													
4	7	8	9	10	11	12							
5													
6	18	17	16	15	14	13							
7	19	20	21	22	23	24							
8													
9													
10	30	29	28	27	26	25							
11													
12	31	32	33	34	35	36							
13													

I, Ronald R. Harris, in a field survey on March 26, 19 97, do hereby certify that under requirements of P.A. 74, Michigan P.A. of 1970, the corner points mentioned in lines 1 and 2 above were in conformance with regulations and rules therefore as required in the current manual of survey instructions of the United States Department of the Interior, Bureau of Land Management or by a decree of a Court of Law and/or that the corner points mentioned in lines 3, 4 and 5 above were in conformance with the rules of the Michigan Board of Land Surveyors or by a Decree of a Court of Law; established, re-established, monumented, re-monumented, recovered, found as expressed below:

NOTE: Not more than 2 corners, all in the same town and range, may be recorded on this certificate.

A. Description of original monument and accessories and/or subsequent restoration:

- 1837 Milny set post
- 1904 Coburn set buggy axle and cedar stake at proportional measurement (B.4, P.20)
- 1968-72 MSHD Job No. 00519A Fnd. wood stake, raised with 3/4" pipe
- 1975 Stevenson P.A.132 (L.002, P.40) Fnd. 3/4" pipe in Mon. Box
- 1975 Stevenson LCRC 340 Fnd. 3/4" pipe in Mon. Box
- 1993 Ruddell P.A.132 (L.005, P.293) Fnd. 3/4" iron in Mon. Box
- 1993 Ruddell LCRC 1234 Fnd. 3/4" iron in Mon. Box
- 1994 Gray LCRC.1264 Fnd. 1-1/2" brass capped rod in Mon. Box

B. Description of corner evidence found and/or method applied in restoring or reestablishing corner:

March 1997 Found 1/2" capped (MDOT) iron rod in Mon. Box (no cover)
Excavated to depth of 4.0 feet;
Found no further evidence or monumentation
Measurements:
B-7 to A-7 = 2557.89' (2557.64' MSHD)
B-7 to C-7 = 2624.31' (2623.97' MSHD)
Fits proportional measurements per County Surveyor notes (1904)

Accepted as the best available evidence for the position of the accepted corner. Corner was approved by the Peer Review Committee on:

C. Description of monument for corner and accessories established to perpetuate locating the position of the corner:

A standard remonumentation corner was set/stamped with corner's code number (B-7) and P.S. 41917.


WITNESSES:

- South 78.10' North face of concrete R/W marker (LCRC 1234)
- NE 94.20' Fnd. nail and cap in 13" Pine (LCRC 1234)
- North 71.70' South face of concrete R/W marker (LCRC 1234)
- South 3.1' Centerline of M-20
- SSE 81.09' Fnd. nail and tag in East face of round fence post (LCRC 1264)

Signed by [Signature]

Date 10/30/97

Surveyor's Michigan License No. 41917

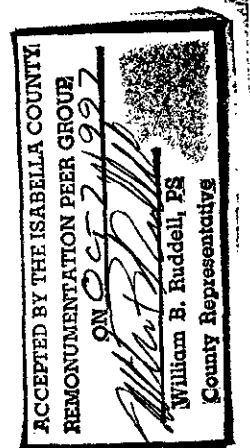

FORM APPROVED BY MICHIGAN STATE SURVEYORS AND SURVEYORS.