

SURVEY &  
REMONUMENTATION

MAR 09 1998

REMONUMENTATION CORNER  
LAND CORNER RECORDATION CERTIFICATE  
Filing Requirement of Act 74, Mich. P.A. 1970

SECTION

For corners in

Isabella  
(County)

Located In:

Corner Code #

9700125614  
Filed for Record in  
ISABELLA COUNTY, MI  
SHARON A BROWN  
On 11-07-1997 At 08:56:19 am.  
RE LAND COR 9.00  
Book OR Vol. 1 Pg. 189 - 189

1. Public Land Survey

T 14N R 6W

C-6

T R

T R

T R

2. Property Controlling  
in Section

S T R

S T R

3. Miscellaneous  
Property in Sec.

S T R

S T R

4. Lot No. \_\_\_\_\_, Recorded Plat \_\_\_\_\_

5. Private Claims \_\_\_\_\_

Register of Deeds Stamp & File Number

	A	B	C	D	E	F	G	H	I	J	K	L	M
1													
2	6	5	4	3	2	1							
3													
4	7	8	9	10	11	12							
5													
6	18	17	16	15	14	13							
7													
8	19	20	21	22	23	24							
9													
10	30	29	28	27	26	25							
11													
12	31	32	33	34	35	36							

6. Ronald R. Harris


in a field survey on March 26, 19 97

do hereby certify that under requirements of P.A. 74, Michigan P.A. of 1970, the corner points mentioned in lines 1 and 2 above were in conformance with regulations and rules therefore as required in the current manual of survey instructions of the United States Department of the Interior, Bureau of Land Management or by a decree of a Court of Law and/or that the corner points mentioned in lines 3, 4 and 5 above were in conformance with the rules of the Michigan Board of Land Surveyors or by a Decree of a Court of Law; established, re-established, monumented, re-monumented, recovered, found as expressed below:

NOTE: Not more than 2 corners, all in the same town and range, may be recorded on this certificate.

A. Description of original monument and accessories and/or subsequent restoration:

1837 Milny set post  
unknown no record (B.4, P.50)  
1968-72 MSHD Job No. 00519A Fnd. 5/8" iron rod

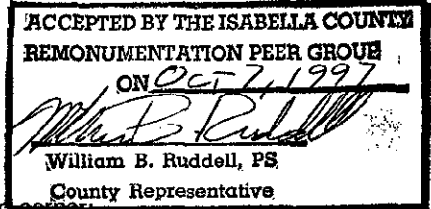

B. Description of corner evidence found and/or method applied in restoring or reestablishing corner:

March 1997 Found 1/2" capped (MDOT) iron rod that fits two (2) MSHD witnesses  
Excavated to depth of 1.0 feet, fnd. 5/8"x62" rod, leaning SE'ly next to position of capped iron. Continued excavation to 3 feet.  
Found no further evidence or monumentation  
Measurements:  
C-6 to C-5 = 2632.42'  
C-6 to C-7 = 2628.25' (2628.02' MSHD)  
No visible occupation to the West

Accepted as the best available evidence for the position of the accepted corner. Corner was approved by the Peer Review Committee on:

C. Description of monument for corner and accessories established to perpetuate locating the position of the corner:

A standard remonumentation corner was set/stamped with corner's code number (C-6), and P.S. 41917.

WITNESSES:

N15E 93.20' Fnd. MDOT witness nail in W. face 12" pine  
S85W 47.75' Fnd. MDOT witness nail in N. face 14" maple  
ENE 121.88' Set nail and tag in S. face twin 14" oak  
North 39.0' Centerline W. Broadway Rd. (Broadway angles to the North approx. 600 ft. East of corner)  
West 7.0' Centerline S. Sherman Rd.

Signed by Reed

Date 10/30/97

Surveyor's Michigan License No. 41917

