

**SURVEY &
REMONUMENTATION**

MAR 09 1998

**REMONUMENTATION CORNER
LAND CORNER RECORDATION CERTIFICATE
Filing Requirement of Act 74, Mich. P.A. 1970**

SECTION

For corners in

Isabella
(County)

Located In:

Corner Code #

9700125615

Filed for Record in
ISABELLA COUNTY, MI
SHARON A BROWN
On 11-07-1997 At 08:56:25 am.
RE LAND COR 9.00
Book OR Vol. 1 Pg. 190 - 190

1. Public Land Survey	T 14N R 6W	C-7
	T R	
	T R	
	T R	
2. Property Controlling in Section	S T R	
	S T R	
3. Miscellaneous Property in Sec.	S T R	
	S T R	

Register of Deeds Stamp & File Number

4. Lot No. _____, Recorded Plat _____
5. Private Claims _____

	A	B	C	D	E	F	G	H	I	J	K	L	M
1													
2	6	5	4	3	2	1							
3													
4	7	8	9	10	11	12							
5													
6	18	17	16	15	14	13							
7													
8	19	20	21	22	23	24							
9													
10	30	29	28	27	26	25							
11													
12	31	32	33	34	35	36							
13													

I, Ronald R. Harris, in a field survey on March 26, 19 97, do hereby certify that under requirements of P.A. 74, Michigan P.A. of 1970, the corner points mentioned in lines 1 and 2 above were in conformance with regulations and rules therefore as required in the current manual of survey instructions of the United States Department of the Interior, Bureau of Land Management or by a decree of a Court of Law and/or that the corner points mentioned in lines 3, 4 and 5 above were in conformance with the rules of the Michigan Board of Land Surveyors or by a Decree of a Court of Law; established, re-established, monumented, re-monumented, recovered, found as expressed below:


NOTE: Not more than 2 corners, all in the same town and range, may be recorded on this certificate.

A. Description of original monument and accessories and/or subsequent restoration:

- 1837 Milny set post
- 1904 Denslow stone/stake (B.4, P.20) (L.1, P.196)
- unknown surveyor and date stake in swamp (B.4, P.50)
- 1968-72 MSHD Job No. 00519A Fnd. stake/stones, raised with 3/4" pipe
- 1978 Ruddell P.A.132 (L.003, P.218) wood stake/stone
- 1978 Ruddell LCRC 519 Fnd. 3/4" pipe in Mon. Box

B. Description of corner evidence found and/or method applied in restoring or reestablishing corner:

March 1997 Found 3/4" iron stake in Mon. Box
Excavated to depth of 4.0 feet
Found no further evidence or monumentation
Measurements:
C-7 to B-7 = 2624.31' (2623.97' MSHD)
C-7 to C-8 = 2612.99' (2613.16' MSHD)
C-7 to C-6 = 2628.25' (2628.02' MSHD)
C-7 to D-7 = 2627.45' (2626.94' MSHD)

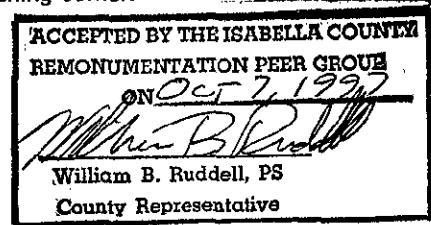

Accepted as the best available evidence for the position of the accepted corner. Corner was approved by the Peer Review Committee on:

C. Description of monument for corner and accessories established to perpetuate locating the position of the corner:

A standard remonumentation corner was set/stamped with corner's code number (C-7) and P.S. 41917.

WITNESSES:

- SW 56.70' Fnd. nail and tag in E. face P.P.
- South 39.75' N. face concrete R/W marker
- ENE 115.90' S. edge of "M-20" sign
- SW 51.90' E. edge of gas pipeline marker
- North 35.5' Centerline of M-20



Signed by [Signature]

Date 10/30/97

Surveyor's Michigan License No. 41917

FORM APPROVED BY MICHIGAN STATE BOARD OF LAND SURVEYORS.