

SURVEY & REMONUMENTATION

MAR 09 1998

REMONUMENTATION CORNER LAND CORNER RECORDATION CERTIFICATE

Filing Requirement of Act 74, Mich. P.A. 1970

SECTION

For corners in

Isabella (County)

Located in:

Corner Code #

9700125616 Filed for Record in ISABELLA COUNTY, MI SHARON A BROWN On 11-07-1997 At 08:56:30 am. RE LAND COR 9.00 Book OR Vol. 1 Pg. 191 - 191

Register of Deeds Stamp & File Number

- 1. Public Land Survey T 14N R 6W C-8
2. Property Controlling in Section S T R
3. Miscellaneous Property in Sec. S T R
4. Lot No. Recorded Plat
5. Private Claims

Grid table with columns A-M and rows 1-13. Contains numbers 1-36 in a grid pattern.

I, Ronald R. Harris, in a field survey on March 26, 19 97, do hereby certify that under requirements of P.A. 74, Michigan P.A. of 1970, the corner points mentioned in lines 1 and 2 above were in conformance with regulations and rules therefore as required in the current manual of survey instructions of the United States Department of the Interior, Bureau of Land Management or by a decree of a Court of Law and/or that the corner points mentioned in lines 3, 4 and 5 above were in conformance with the rules of the Michigan Board of Land Surveyors or by a Decree of a Court of Law; established, re-established, monumented, re-monumented, recovered, found as expressed below:

NOTE: Not more than 2 corners, all in the same town and range, may be recorded on this certificate.


A. Description of original monument and accessories and/or subsequent restoration:

- 1837 Milny set post
1904 Denslow Fnd. corner, set buggy axle (B.4, P.20) (L.1, P.196)
1968-72 MSHD Job No. 00519A Fnd. axle shaft by fence corner
1948 Recorded plat of "Fowler Park" (L.4. P.229)
1982 Mueller P.A.132 (L.004, P.13) location per MSHD records
1994 Gray LCRC 1264 set iron at intersection of three (3) way fences

B. Description of corner evidence found and/or method applied in restoring or reestablishing corner:

March 1997 Found axle shaft per MSHD records. Also found capped iron per LCRC 1264 Did not excavate area Found no further evidence Measurements: C-7 to C-8 = 2612.99' (2613.16' MSHD)

Accepted as the best available evidence for the position of the accepted corner. Corner was approved by the Peer Review Committee on:

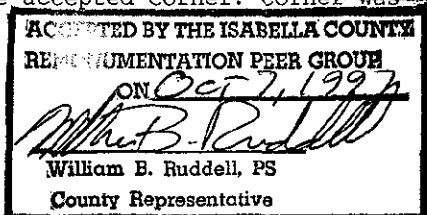

C. Description of monument for corner and accessories established to perpetuate locating the position of the corner:

A standard remonumentation corner was set/stamped with corner's code number (C-8) and P.S. 41917.

WITNESSES:

- NNW 13.60' set nail and cap in E. face fence post
South 18.82' Fnd. MDOT tag in E. face fence post (MSHD)
SSW 45.42' Fnd. nail in NW face 10" "dead" tree
NW 2.51' steel fence post (MSHD)
NW 2.72' Fnd. capped iron 0.2' west of steel fence post (LCRC 1264)
WSW 37.37' set nail and cap in N. face 6" "dead" tree



Signed by [Signature] Date 10/30/97

Surveyor's Michigan License No. 41917

FORM APPROVED BY MICHIGAN STATE BOARD OF LAND SURVEYORS.