

MAR 09 1998

SECTION

REMONUMENTATION CORNER

LAND CORNER RECORDATION CERTIFICATE

Filing Requirement of Act 74, Mich. P.A. 1970

9700125617
 Filed for Record in
 ISABELLA COUNTY, MI
 SHARON A BROWN
 On 11-07-1997 At 08:56:35 am.
 RE LAND COR 9.00
 Book DR Vol. 1 Pg. 192 - 192

Register of Deeds Stamp & File Number

For corners in Isabella (County) Located In: Corner Code #

1. Public Land Survey T 14N R 6W D-7
 T R
 T R
 T R

2. Property Controlling S T R
 in Section S T R

3. Miscellaneous S T R
 Property in Sec. S T R

4. Lot No. _____, Recorded Plat _____

5. Private Claims _____

	A	B	C	D	E	F	G	H	I	J	K	L	M
2	6	5	4	3	2	1							
3													
4	7	8	9	10	11	12							
5													
6	18	17	16	15	14	13							
7													
8	19	20	21	22	23	24							
9													
10	30	29	28	27	26	25							
11													
12	31	32	33	34	35	36							
13													

I, Ronald R. Harris, in a field survey on March 26, 19 97, do hereby certify that under requirements of P.A. 74, Michigan P.A. of 1970, the corner points mentioned in lines 1 and 2 above were in conformance with regulations and rules therefore as required in the current manual of survey instructions of the United States Department of the Interior, Bureau of Land Management or by a decree of a Court of Law and/or that the corner points mentioned in lines 3, 4 and 5 above were in conformance with the rules of the Michigan Board of Land Surveyors or by a Decree of a Court of Law; established, re-established, monumented, re-monumented, recovered, found as expressed below:

NOTE: Not more than 2 corners, all in the same town and range, may be recorded on this certificate.

A. Description of original monument and accessories and/or subsequent restoration:
 1837 Milny set post
 unknown date & surveyor stake on edge of old road bed (B.4, P.50)
 1968-72 MSHD Job No. 00519A Set 3/4" pipe
 1978 Ruddell P.A.132 (L.003, P.218) Fnd. stone (same witnesses as MSHD)
 1978 Ruddell LCRC 519 Fnd. 3/4" pipe in Mon. Box

B. Description of corner evidence found and/or method applied in restoring or reestablishing corner:
 March 1997 Found 1/2" capped pipe (MDOT) in Mon. Box
 Excavated to depth of 3.8 feet
 Found no further evidence
 Measurements:
 D-7 to C-7 = 2627.42' (2626.97' MSHD)
 D-7 to E-7 = 2633.82' (2633.37' MSHD)


Accepted as the best available evidence for the position of the accepted corner. Corner was approved by the Peer Review Committee on:

C. Description of monument for corner and accessories established to perpetuate locating the position of the corner:
 A standard remonumentation corner was set/stamped with corner's code number (D-7) and P.S. 41917.

WITNESSES:

- North 71.40' Fnd. nail in top of fence post
- ENE 141.70' set nail and cap in S. face 16" poplar
- ESE 125.45' set nail and cap in N. face 18" poplar
- South 5.00' set P.K. nail in centerline of M-20

Signed by [Signature] Date 10/30/97
 Surveyor's Michigan License No. 41917

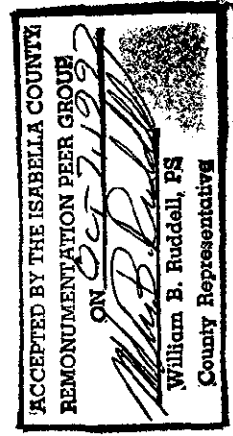

FORM APPROVED BY MICHIGAN STATE BOARD OF LAND SURVEYORS.