

SURVEY &  
REMONUMENTATION

MAR 09 1998

REMONUMENTATION CORNER  
LAND CORNER RECORDATION CERTIFICATE  
Filing Requirement of Act 74, Mich. P.A. 1970

SECTION

For corners in

Isabella  
(County)

Located In:

Corner Code #

1. Public Land Survey

T 14N R 6W

E-6

T \_\_\_\_\_ R \_\_\_\_\_

T \_\_\_\_\_ R \_\_\_\_\_

T \_\_\_\_\_ R \_\_\_\_\_

T \_\_\_\_\_ R \_\_\_\_\_

2. Property Controlling  
In Section

S \_\_\_\_\_ T \_\_\_\_\_ R \_\_\_\_\_

S \_\_\_\_\_ T \_\_\_\_\_ R \_\_\_\_\_

3. Miscellaneous  
Property in Sec.

S \_\_\_\_\_ T \_\_\_\_\_ R \_\_\_\_\_

S \_\_\_\_\_ T \_\_\_\_\_ R \_\_\_\_\_

4. Lot No. \_\_\_\_\_, Recorded Plat \_\_\_\_\_

5. Private Claims \_\_\_\_\_

9700125618  
Filed for Record in  
ISABELLA COUNTY, MI  
SHARON A BROWN  
On 11-07-1997 At 08:56:40 am.  
RE LAND COR 9.00  
Book OR Vol. 1 Pg. 193 - 193

Register of Deeds Stamp & File Number


	A	B	C	D	E	F	G	H	I	J	K	L	M
2	6	5	4	3	2	1							
3													
4	7	8	9	10	11	12							
5													
6	18	17	16	15	14	13							
7													
8	19	20	21	22	23	24							
9													
10	30	29	28	27	26	25							
11													
12	31	32	33	34	35	36							
13													

I, Ronald R. Harris, in a field survey on March 26, 19 97,  
do hereby certify that under requirements of P.A. 74, Michigan P.A. of 1970, the corner points mentioned  
in lines 1 and 2 above were in conformance with regulations and rules therefore as required in the  
current manual of survey instructions of the United States Department of the Interior, Bureau of Land  
Management or by a decree of a Court of Law and/or that the corner points mentioned in lines 3, 4 and 5  
above were in conformance with the rules of the Michigan Board of Land Surveyors or by a Decree of a  
Court of Law; established, re-established, monumented, re-monumented, recovered, found as  
expressed below:

NOTE: Not more than 2 corners, all in the same town and range, may be recorded  
on this certificate.

A. Description of original monument and accessories and/or subsequent restoration:

1837 Milny set post  
1903 Denslow set stake at equi-distance (B.3, P.205)  
1968-72 MSHD Job No. 00519A Fnd. angle iron  
1977 Fluharty P.A.132 (L:002 P.491) Fnd. angle iron  
1977 Fluharty LCRC 407 Fnd. angle iron

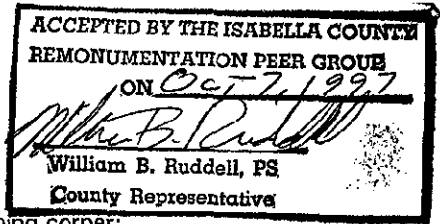

B. Description of corner evidence found and/or method applied in restoring or reestablishing corner:

March 1997 Found angle iron 0.2' below surface  
Excavated and found a rock along side of angle iron 1.3' to 2.0' down.  
Continued excavation to a depth of 3 feet, found smaller stones and the remains of a  
hand revolver 1 foot, more or less, NW'ly of angle iron  
Found no further evidence

Measurements:

E-6 to E-5 = 2621.54' (2641.65' (40.02-1/2 chains) CSR)

E-6 to E-7 = 2631.79' (2631.77' MSHD) (2641.65' (40.02 1/2 chains) CSR)

Fits an occupied line that is approx. 1/4 mile E of this corner ( line running

East & West), also fits approx. centerline of Broadway Road.


Accepted as the best available evidence for the position of the accepted corner. Corner was approved by  
the Peer Review Committee on

C. Description of monument for corner and accessories established to perpetuate locating position of the corner:

A standard remonumentation corner was set/stamped with corner's code number (E-6) and P.S. 41917.

WITNESSES:

NW 40.35' SE corner of 5-1/2"x9" corner fence post (at ground level)  
N52E 18.11' End. form nail in S. face twin 40" maple (LCRC 407)  
WNW 53.33' set nail and tag in SW face P.P.  
WSW 65.59' set nail and tag in NW face guy pole

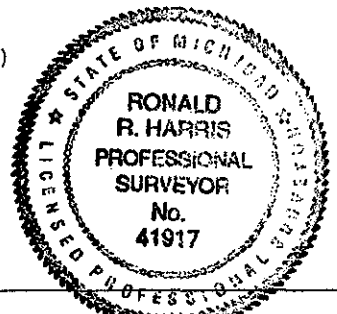

Signed by R. R. Harris

Date 10/30/97

Surveyor's Michigan License No. 41917

FORM APPROVED BY MICHIGAN STATE BOARD OF LAND SURVEYORS.