

REMONUMENTATION

MAY 05 1997

117197

COMMISSION

REMONUMENTATION CORNER

LAND CORNER RECORDATION CERTIFICATE

Filing Requirement of Act 74, Mich. P.A. 1970

STATE OF MICHIGAN  
COUNTY OF ISABELLA  
REGISTER OF DEEDS

JAN 23 1 12 PM '97  
000157

SHARON A. BROWN  
REGISTER OF DEEDS

For corners in

Isabella  
(County)

Located In:

Corner Code #

- 1. Public Land Survey T 14N R 6W
- T R
- T R
- T R
- 2. Property Controlling S T R
- in Section S T R
- 3. Miscellaneous S T R
- Property in Sec. S T R

E-7

Register of Deeds Stamp & File Number

- 4. Lot No. \_\_\_\_\_ Recorded Plat \_\_\_\_\_
- 5. Private Claims \_\_\_\_\_

I, Ronald R. Harris, in a field survey on August 16, 19 96, do hereby certify that under requirements of P.A. 74, Michigan P.A. of 1970, the corner points mentioned in lines 1 and 2 above were in conformance with regulations and rules therefore as required in the current manual of survey instructions of the United States Department of the Interior, Bureau of Land Management or by a decree of a Court of Law and/or that the corner points mentioned in lines 3, 4 and 5 above were in conformance with the rules of the Michigan Board of Land Surveyors or by a Decree of a Court of Law; established, re-established, monumented, re-monumented, recovered, found as expressed below:


NOTE: Not more than 4 corners, all in the same town and range, may be recorded on this certificate.

A. Description of original monument and accessories and/or subsequent restoration:

- 1837 Post by John Milny
- 1903 Survey by Denslow & Coburn. Recorded Bk 3 P 205 County Surveyor Records. Found old stake. Set 4 x 4 stake
- 1905 Survey by Coburn. Recorded Bk 4 P 40, County Surveyor Records. Stake
- No date or identity. Recorded Bk 4 P 50. (later entry). Believed to be a pipe.
- + 1970 M-20 plans by MSHD (Job No. 00519). Found 1" pipe. Raised with 3/4" pipe
- 1976 LCRC by Fluharty. Recorded P 407. Found 5/8" iron in mon box Survey by H.L. Fluharty. L2, P 491

B. Description of corner evidence found and/or method applied in restoring or reestablishing corner:

- Aug 1996 Found 1" rod in mon box (1976) Witness from LCRC. P 407 Check
- Oct 1996 Witnessed and removed corner. Augered down through mon box to depth of 5.2'. At that depth, hit unmovable object. Filled and reset corner (20' + fill area)

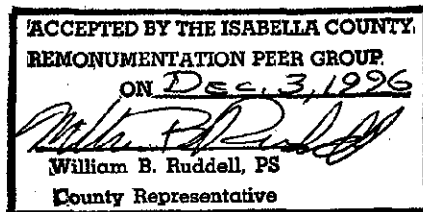

C. Description of monument for corner and accessories established to perpetuate locating the position of the corner:

A standard remonumentation corner was set/stamped with corners code number (E-7) and P.S. 41917 in monument box and is accepted as the best available evidence of the position of the original corner.

WITNESSES:

- N13W 124.42' Centerline of steel fence post
- N18E 122.92' Centerline of steel fence post
- S83W 26.07' Centerline of stop sign post
- S80E 21.27' Back curb at 1st joint from North on curb return
- S 59' Centerline of M-20

Signed by R.R.A. Date 1/22/97  
Surveyor's Michigan License No. 41917

