

SURVEY &  
REMONUMENTATION

MAR 09 1998

REMONUMENTATION CORNER

LAND CORNER RECORDATION CERTIFICATE

Filing Requirement of Act 74, Mich. P.A. 1970

SECTION

For corners in

Isabella  
(County)

Located In:

Corner Code #

9700125619  
Filed for Record in  
ISABELLA COUNTY, MI  
SHARON A BROWN  
On 11-07-1997 At 08:56:45 am.  
RE LAND COR 9.00  
Book OR Vol. 1 Pg. 194 - 194

Register of Deeds Stamp & File Number

1. Public Land Survey

T 14N R 6W

E-8

2. Property Controlling  
in Section

S T R  
S T R

3. Miscellaneous  
Property in Sec.

S T R  
S T R

4. Lot No. \_\_\_\_\_, Recorded Plat \_\_\_\_\_

5. Private Claims \_\_\_\_\_

	A	B	C	D	E	F	G	H	I	J	K	L	M
1													
2	6	5	4	3	2	1							
3													
4	7	8	9	10	11	12							
5													
6	18	17	16	15	14	13							
7													
8	19	20	21	22	23	24							
9													
10	30	29	28	27	26	25							
11													
12	31	32	33	34	35	36							
13													

I, Ronald R. Harris, in a field survey on March 26, 19 97, do hereby certify that under requirements of P.A. 74, Michigan P.A. of 1970, the corner points mentioned in lines 1 and 2 above were in conformance with regulations and rules therefore as required in the current manual of survey instructions of the United States Department of the Interior, Bureau of Land Management or by a decree of a Court of Law and/or that the corner points mentioned in lines 3, 4 and 5 above were in conformance with the rules of the Michigan Board of Land Surveyors or by a Decree of a Court of Law; established, re-established, monumented, re-monumented, recovered, found as expressed below:

NOTE: Not more than 2 corners, all in the same town and range, may be recorded on this certificate.


A. Description of original monument and accessories and/or subsequent restoration:

1837 Milny set post  
1905 Denslow Fnd. old B.T.'s in good condition (B.4 P.40)  
1968-72 MSHD Job No. 00519A set 3/4" pipe (apparently set at a doubled distance, and on line extended, over a found pine stake at the N 1/8 corner)  
1988 Mueller LCRC 905 Fnd. 3/4" pipe per MSHD

B. Description of corner evidence found and/or method applied in restoring or reestablishing corner:

March 1997 Found 3/4" pipe with the top 5" bent over  
Excavated to straight portion, 6" below.  
Continued excavation, found wood fragments 18" down, also found a 2.3' long ti-rod, 4.7' northerly of pipe. Excavated around ti-rod and found very large rock (2'x3.5')  
Found no further evidence, held position of pipe  
Measurements:  
E-8 to E-7 = 2618.03' (2617.86' MSHD)  
E-8 to E-9 = 2615.09' (2614.82' MSHD)

Accepted as the best available evidence for the position of the accepted corner was approved by the Peer Review Committee on:

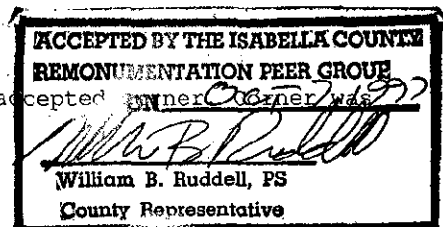

C. Description of monument for corner and accessories established to perpetuate locating the position of the corner:

A standard remonumentation corner was set/stamped with corner's code number (E-8) and P.S. 41917.

WITNESSES:

SSW 74.71' Fnd. nail and tag in E. face P.P. (LCRC 905)  
WNW 72.45' Fnd. nail and tag in S. face 16" cherry (LCRC 905)  
NW 47.96' top centerline phone box riser (LCRC 905)  
North 25'+ fenceline to West  
SW 51.15' set nail and tag in 16" spruce

Signed by

*R. Harris*

Date

10/30/97

Surveyor's Michigan License No. 41917

FORM APPROVED BY MICHIGAN STATE BOARD OF LAND SURVEYORS.

