

**SURVEY &
REMONUMENTATION**

MAR 09 1998

**REMONUMENTATION CORNER
LAND CORNER RECORDATION CERTIFICATE
Filing Requirement of Act 74, Mich. P.A. 1970**

SECTION

For corners in

Isabella
(County)

Located In:

Corner Code #

1. Public Land Survey

T 14N R 6W

E-9

2. Property Controlling
in Section

S T R
S T R

3. Miscellaneous
Property in Sec.

S T R
S T R

4. Lot No. _____, Recorded Plat _____

5. Private Claims _____

9700125620

Filed for Record in
ISABELLA COUNTY, MI

SHARON A BROWN

On 11-07-1997 At 08:57:00 am.

RE LAND COR 9.00

Book OR Vol. 1 Pg. 195 - 195

Register of Deeds Stamp & File Number

	A	B	C	D	E	F	G	H	I	J	K	L	M
1													
2	6	5	4	3	2	1							
3													
4	7	8	9	10	11	12							
5													
6	18	17	16	15	14	13							
7													
8	19	20	21	22	23	24							
9													
10	30	29	28	27	26	25							
11													
12	31	32	33	34	35	36							
13													

I, Ronald R. Harris

in a field survey on March 26, 19 97

do hereby certify that under requirements of P.A. 74, Michigan P.A. of 1970, the corner points mentioned in lines 1 and 2 above were in conformance with regulations and rules therefore as required in the current manual of survey instructions of the United States Department of the Interior, Bureau of Land Management or by a decree of a Court of Law and/or that the corner points mentioned in lines 3, 4 and 5 above were in conformance with the rules of the Michigan Board of Land Surveyors or by a Decree of a Court of Law; established, re-established, monumented, re-monumented, recovered, found as expressed below:

NOTE: Not more than 2 corners, all in the same town and range, may be recorded on this certificate.

A. Description of original monument and accessories and/or subsequent restoration:

- 1837 Milny set post
- 1905 Coburn 6"x10"x36" stone (B.4 P.40)
- 1968-72 MSHD Job No. 00519A Fnd. 6"x10"x36" stone, set 1" iron bar along side
- 1984 Ruddell P.A.132 (L.004 P.324) Fnd. solid shaft
- 1988 Mueller LCRC 905 Fnd. 1-1/4" bar

B. Description of corner evidence found and/or method applied in restoring or reestablishing corner:

- March 1997 Found 1" iron rod with top bent
- Excavated and found 6"x6"x8" stone along side, 1.1 feet below grade.
- Found no further evidence
- Measurements:
E-9 to E-8 = 2615.08' (2614.82' MSHD)


Accepted as the best available evidence for the position of the accepted corner. Corner was approved by the Peer Review Committee on:

C. Description of monument for corner and accessories established to perpetuate locating the position of the corner:

A standard remonumentation corner was set/stamped with corner's corner number (E-9) and P.S. 41917.

WITNESSES:

- SW 72.35' Fnd. nail and cap in SE face P.P. (LCRC 905)
- NW 51.55' centerline phone box riser (LCRC 905)
- SSE 83.32' Fnd. nail and tag in W. face twin 8" apple (LCRC 905)
- NNE 89.85' Fnd. nail and tag in W. face 10" red pine (LCRC 905)
- N45E 73'+ Fnd. large stump (MSHD)
- S70W 82.5'+ Fnd. large stump (MSHD)
- NNE 49.57' Set nail and tag in 26" stump

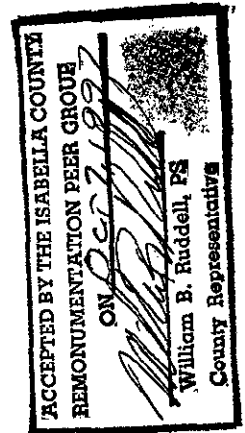

Signed by

R. R. Harris

Date

10/30/97

Surveyor's Michigan License No.

41917

FORM APPROVED BY MICHIGAN STATE BOARD OF LAND SURVEYORS.