

SURVEY &
REMONUMENTATION

MAR 09 1998

SECTION

REMONUMENTATION CORNER
LAND CORNER RECORDATION CERTIFICATE
Filing Requirement of Act 74, Mich. P.A. 1970

corners in
Isabella
(County)

Located In: Corner Code #

Public Land Survey T 14N R 6W G-6

Property Controlling in Section S T R

Miscellaneous Property in Sec. S T R

Lot No. _____, Recorded Plat _____

Private Claims _____

9700125621
Filed for Record in
ISABELLA COUNTY, MI
SHARON A BROWN
On 11-07-1997 At 08:57:05 am.
RE LAND COR 9.00
Book OR Vol. 1 Pg. 196 - 196

Register of Deeds Stamp & File Number


	A	B	C	D	E	F	G	H	I	J	K	L	M
1													
2	6	5	4	3	2	1							
3													
4	7	8	9	10	11	12							
5													
6	18	17	16	15	14	13							
7													
8	19	20	21	22	23	24							
9													
10	30	29	28	27	26	25							
11													
12	31	32	33	34	35	36							
13													

Ronald R. Harris, in a field survey on March 26, 1997, hereby certify that under requirements of P.A. 74, Michigan P.A. of 1970, the corner points mentioned in lines 1 and 2 above were in conformance with regulations and rules therefore as required in the current manual of survey instructions of the United States Department of the Interior, Bureau of Land Management or by a decree of a Court of Law and/or that the corner points mentioned in lines 3, 4 and 5 above were in conformance with the rules of the Michigan Board of Land Surveyors or by a Decree of a Court of Law, established, re-established, monumented, re-monumented, recovered, found as expressed below:

NOTE: Not more than 2 corners, all in the same town and range, may be recorded on this certificate.

A. Description of original monument and accessories and/or subsequent restoration:

- 1837 Milny set post
- 1903 Denslow/Coburn no record (E.3 P.205) (L.1 P.152)
- 1903 Denslow/Coburn set post/gas pipe at equi-distance (L.1 P.150)
- 1968-72 MSHD Job No. 00519A Fnd. 1/2" pipe
- 1980 Wilcox (LCRC 609) Fnd. 1/2" pipe

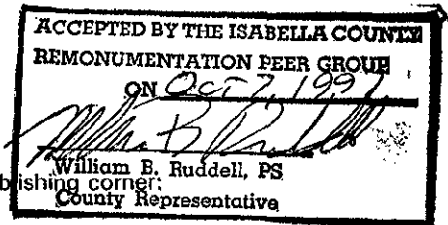

B. Description of corner evidence found and/or method applied in restoring or reestablishing corner:

- March 1997 Found 1-1/4" pipe 6" below grade in mon. box
Excavated and found 1/2" pipe under 1-1/4" pipe, 2.3 feet below grade, slightly off center.
Found no further evidence
Matches closely with ICRC & MSHD witness notes:
N85W 59.99' 24" oak
East 39.80' 20" oak
Occupied fence line to the East of this position.
Measurements:
G-6 to G-5 = 2630.38' (2631.09' {39.86 1/2 chains} CSR)
G-6 to G-7 = 2625.51' (2626.03 MSHD) (2631.09' {39.86 1/2 chains} CSR)

Accepted as the best available evidence for the position of the accepted corner. Corner was approved by the Peer Review Committee on:

C. Description of monument for corner and accessories established to perpetuate locating the position of the corner:

A standard remonumentation corner was set/stamped with corner's code number (G-6) and P.S. 41917.

WITNESSES:

- SSE 45.05' Set nail and cap in top of guard rail post
- East 39.90' Set nail and cap in N. face twin 24" oak (possible LCRC 609)
- West 59.48' Set nail and cap in S. face 30" oak (possible LCRC 609)
- WNW 69.47' Set nail and cap in SW face 8" oak

Signed by R. R. Harris

Date 10/30/97

Surveyor's Michigan License No. 41917



FORM APPROVED BY MICHIGAN STATE BOARD OF LAND SURVEYORS.