

**SURVEY &  
REMONUMENTATION**

MAR 09 1998

**REMONUMENTATION CORNER  
LAND CORNER RECORDATION CERTIFICATE  
Filing Requirement of Act 74, Mich. P.A. 1970**

**SECTION**

corners in  
Isabella  
(County)

Located In: Corner Code #

- Public Land Survey T 14N R 6W G-7  
T R  
T R  
T R  
- Property Controlling S T R  
in Section S T R  
- Miscellaneous S T R  
Property in Sec. S T R

9700125622  
Filed for Record in  
ISABELLA COUNTY, MI  
SHARON A BROWN  
On 11-07-1997 At 08:57:10 am.  
RE LAND CDR 9.00  
Book DR Vol. 1 Pg. 197 - 197

Register of Deeds Stamp & File Number

- Lot No. \_\_\_\_\_, Recorded Plat \_\_\_\_\_  
- Private Claims \_\_\_\_\_

1	A	B	C	D	E	F	G	H	I	J	K	L	M
2	6	5	4	3	2	1							
3													
4	7	8	9	10	11	12							
5													
6	18	17	16	15	14	13							
7													
8	19	20	21	22	23	24							
9													
10	30	29	28	27	26	25							
11													
12	31	32	33	34	35	36							
13													

Ronald R. Harris, in a field survey on March 26, 19 97,  
I hereby certify that under requirements of P.A. 74, Michigan P.A. of 1970, the corner points mentioned  
lines 1 and 2 above were in conformance with regulations and rules therefore as required in the  
current manual of survey instructions of the United States Department of the Interior, Bureau of Land  
Management or by a decree of a Court of Law and/or that the corner points mentioned in lines 3, 4 and 5  
above were in conformance with the rules of the Michigan Board of Land Surveyors or by a Decree of a  
Court of Law; established, re-established, monumented, re-monumented, recovered, found as  
expressed below:

**NOTE: Not more than 2 corners, all in the same town and range, may be recorded  
on this certificate.**

- Description of original monument and accessories and/or subsequent restoration:

- 1837 Milny set post
- 1899 Denslow/Coburn iron bar (B.3 P.134) (L.1 P.12)
- 1903 Denslow/Coburn iron rod (B.3 P.204) (L.1 P.150)
- 1903 Denslow/Coburn no record (B.3 P.205) (L.1 P.152)
- 1905 Denslow/Coburn iron bar (B.4 P.40)
- 1968-72 MSHD Job No. 00519A Fnd. 1" pipe
- 1970 Private records fnd. pine stake, raised with 3/4" pipe


- Description of corner evidence found and/or method applied in restoring or reestablishing corner:

March 1997 Found 1/2" capped MDOT pipe in Mon. Box  
Excavated to a depth of 4.1 feet below grade  
Found no further evidence

Measurements:

- G-7 to G-8 = 2627.40' (2627.39' MSHD)
- G-7 to G-6 = 2625.51' (2626.03 MSHD) (2631.09' {39.86 1/2 chains} CSR)
- G-7 to F-7 = 2649.21' (2649.38' MSHD)
- G-7 to H-7 = 2603.25' (2603.18' MSHD)

Accepted as the best available evidence for the position of the accepted corner. Corner was  
approved by the Peer Review Committee on:

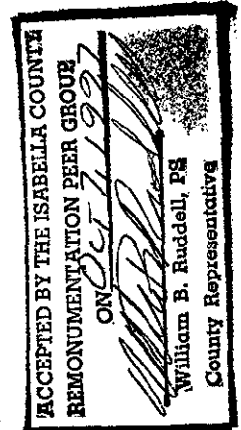

- Description of monument for corner and accessories established to perpetuate locating the position of the corner:

A standard remonumentation corner was set/stamped with corner's code number (G-7) and P.S. 41917.

WITNESSES:

- SW 42.30' back of curb at second expansion joint from west
- SE 42.95' back of curb at second expansion joint from east
- NNE 86.15' west side of "ADOPT HIGHWAY" sign post, 0.5' above grade
- WNW 26.20' east leg of stop sign, at grade

Signed by R.R.H.

Date 10/30/97

Surveyor's Michigan License No. 41917



FORM APPROVED BY MICHIGAN STATE BOARD OF SURVEYORS.