

**SURVEY &  
REMONUMENTATION**

MAR 09 1998

**REMONUMENTATION CORNER  
LAND CORNER RECORDATION CERTIFICATE  
Filing Requirement of Act 74, Mich. P.A. 1970**

**SECTION**

For corners in  
Isabella  
(County)

Located In: \_\_\_\_\_ Corner Code # \_\_\_\_\_

Public Land Survey T 14N R 6W G-8

Property Controlling in Section S \_\_\_\_\_ T \_\_\_\_\_ R \_\_\_\_\_

Miscellaneous Property in Sec. S \_\_\_\_\_ T \_\_\_\_\_ R \_\_\_\_\_

Lot No. \_\_\_\_\_ Recorded Plat \_\_\_\_\_

Private Claims \_\_\_\_\_

9700125623  
Filed for Record in  
ISABELLA COUNTY, MI  
SHARON A BROWN  
On 11-07-1997 At 08:57:15 am.  
RE LAND COR 9.00  
Book OR Vol. 1 Pg. 198 - 198

**Register of Deeds Stamp & File Number**

	A	B	C	D	E	F	G	H	I	J	K	L	M
1													
2	6	5	4	3	2	1							
3													
4	7	8	9	10	11	12							
5													
6	18	17	16	15	14	13							
7													
8	19	20	21	22	23	24							
9													
10	30	29	28	27	26	25							
11													
12	31	32	33	34	35	36							
13													

Ronald R. Harris, in a field survey on March 26, 1997,  
do hereby certify that under requirements of P.A. 74, Michigan P.A. of 1970, the corner points mentioned  
in lines 1 and 2 above were in conformance with regulations and rules therefore as required in the  
current manual of survey instructions of the United States Department of the Interior, Bureau of Land  
Management or by a decree of a Court of Law and/or that the corner points mentioned in lines 3, 4 and 5  
above were in conformance with the rules of the Michigan Board of Land Surveyors or by a Decree of a  
Court of Law; established, re-established, monumented, re-monumented, recovered, found as  
expressed below:

**NOTE: Not more than 2 corners, all in the same town and range, may be recorded on this certificate.**


**A. Description of original monument and accessories and/or subsequent restoration:**

1837 Milny set post  
1899 Denslow/Coburn set iron bar (B.3 P.134) (L.1 P.12)  
1905 Denslow/Coburn iron bar (B.4 P.40)  
1968-72 MSHD Job No. 00519A Fnd. iron bar

**B. Description of corner evidence found and/or method applied in restoring or reestablishing corner:**

March 1997 Found 1/2"x2"x18" iron bar in Mon. Box  
Excavated to a depth of 4 feet below grade  
Found no further evidence  
Measurements:  
G-8 to G-7 = 2627.40' (2627.39' MSHD)  
G-8 to G-9 = 2628.97'

Accepted as the best available evidence for the position of the accepted corner. Corner was  
approved by the Peer Review Committee on:

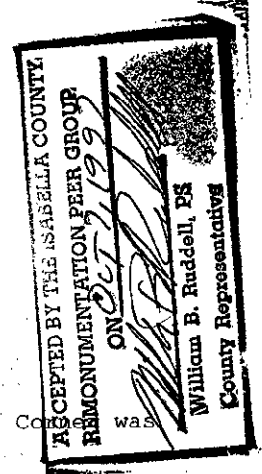

**C. Description of monument for corner and accessories established to perpetuate locating the position of the corner:**

A standard remonumentation corner was set/stamped with corner's code number (G-8) and P.S. 41917.

**WITNESSES:**

West 30.72' Set nail and cap in S. face P.P.  
SW 60.15' Set nail and cap in N. face twin 6" cherry  
East 82.05' Set nail and cap in N. face 30" elm clump  
West 0.8' Centerline Rolland Rd.  
N05W 336.79' Set nail and tag in W. face P.P.



Signed by R.R.H. Date 10/30/97

Surveyor's Michigan License No. 41917

FORM APPROVED BY MICHIGAN STATE BOARD OF LAND SURVEYORS.