

**SURVEY & REMONUMENTATION**

MAR 09 1998

**REMONUMENTATION CORNER  
LAND CORNER RECORDATION CERTIFICATE  
Filing Requirement of Act 74, Mich. P.A. 1970**

SECTION

corners in  
Isabella  
(County)

Located In:

Corner Code #

9700125624

Filed for Record in  
ISABELLA COUNTY, MI  
SHARON A BROWN  
On 11-07-1997 At 08:57:21 am.  
RE LAND COR 9.00  
Book OR Vol. 1 Pg. 199 - 199

- Public Land Survey

T 14N R 6W

H-7

T R

T R

T R

- Property Controlling in Section

S T R

S T R

- Miscellaneous Property in Sec.

S T R

S T R

9700125624

Filed for Record in  
ISABELLA COUNTY, MI  
SHARON A BROWN  
On 11-07-1997 At 08:57:21 am.  
RE LAND COR 9.00  
Book OR Vol. 1 Pg. 199 - 199

- Lot No. \_\_\_\_\_, Recorded Plat \_\_\_\_\_

- Private Claims \_\_\_\_\_

	A	B	C	D	E	F	G	H	I	J	K	L	M
1													
2	6	5	4	3	2	1							
3													
4	7	8	9	10	11	12							
5													
6	18	17	16	15	14	13							
7													
8	19	20	21	22	23	24							
9													
10	30	29	28	27	26	25							
11													
12	31	32	33	34	35	36							
13													

Ronald R. Harris, in a field survey on March 26, 19 97,  
do hereby certify that under requirements of P.A. 74, Michigan P.A. of 1970, the corner points mentioned in lines 1 and 2 above were in conformance with regulations and rules therefore as required in the current manual of survey instructions of the United States Department of the Interior, Bureau of Land Management or by a decree of a Court of Law and/or that the corner points mentioned in lines 3, 4 and 5 above were in conformance with the rules of the Michigan Board of Land Surveyors or by a Decree of a Court of Law, established, re-established, monumented, re-monumented, recovered, found as expressed below:

**NOTE: Not more than 2 corners, all in the same town and range, may be recorded on this certificate.**

A. Description of original monument and accessories and/or subsequent restoration:

- 1837 Milny set post
- 1899 Denslow/Coburn stone marked "C" (B.3 P.134) (L.1 P.12)
- 1903 Denslow/Coburn no record (B.3 P.204) (L.1 P.150)
- 1968-72 MSHD Job No. 00519A Fnd. 5/8" rod, replaced with boat spike
- 1995 Ruddell P.A.132 (L.005 P.497) no record of object

B. Description of corner evidence found and/or method applied in restoring or reestablishing corner:

March 1997 Found 1/2" capped MDOT pipe in Mon. Box  
Excavated to a depth of 4.5 feet below grade  
Found no further evidence  
Measurements:  
H-7 to G-7 = 2603.25' (2603.18' MSHD) (2593.80' {39.30 chains} CSR)  
H-7 to I-7 = 2636.90' (2636.96' MSHD) (2626.14' {39.79 chains} CSR)

Accepted as the best available evidence for the position of the accepted corner. Corner was approved by the Peer Review Committee on:

C. Description of monument for corner and accessories established to perpetuate locating the position of the corner:

A standard remonumentation corner was set/stamped with corner's code number (H-7) and P.S. 41917.


**WITNESSES:**

- NW 21.71' Top centerline W. end of 15" cmp
- North 30.30' S. face on concrete fence post (MSHD)
- NE 124.66' SW corner of house #8478 foundation
- South 102.17' Set nail and tag in W. face P.P.
- S30E 129.76' NW corner of house #8477 foundation (MSHD)
- SE 175.34' Set nail and tag in P.P.

Signed by R.R.H.

Date 10/30/97

Surveyor's Michigan License No. 41917

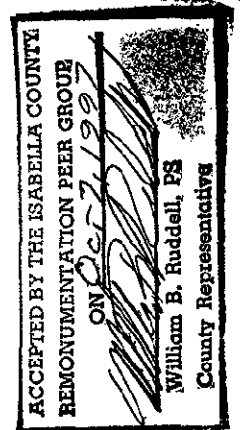

FORM APPROVED BY MICHIGAN STATE BOARD OF LAND SURVEYORS.