

SURVEY &
REMONUMENTATION

MAR 09 1998

REMONUMENTATION CORNER
LAND CORNER RECORDATION CERTIFICATE
Filing Requirement of Act 74, Mich. P.A. 1970

SECTION

or corners in
Isabella
(County)

Located In:

Corner Code #

9700125625
Filed for Record in
ISABELLA COUNTY, MI
SHARON A BROWN
On 11-07-1997 At 08:57:27 am.
RE LAND COR 9.00
Book OR Vol. 1 Pg. 200 - 200

Register of Deeds Stamp & File Number

Public Land Survey	T	14N	R	6W	I-6
	T		R		
	T		R		
	T		R		
Property Controlling in Section	S	T	R		
	S	T	R		
Miscellaneous Property in Sec.	S	T	R		
	S	T	R		

Lot No. _____, Recorded Plat _____
Private Claims _____

	A	B	C	D	E	F	G	H	I	J	K	L	M
1													
2	6	5	4	3	2	1							
3													
4	7	8	9	10	11	12							
5													
6	18	17	16	15	14	13							
7													
8	19	20	21	22	23	24							
9													
10	30	29	28	27	26	25							
11													
12	31	32	33	34	35	36							
13													

Ronald R. Harris, in a field survey on March 26, 19 97, hereby certify that under requirements of P.A. 74, Michigan P.A. of 1970, the corner points mentioned in lines 1 and 2 above were in conformance with regulations and rules therefore as required in the current manual of survey instructions of the United States Department of the Interior, Bureau of Land Management or by a decree of a Court of Law and/or that the corner points mentioned in lines 3, 4 and 5 above were in conformance with the rules of the Michigan Board of Land Surveyors or by a Decree of a Court of Law; established, re-established, monumented, re-monumented, recovered, found as expressed below:

NOTE: Not more than 2 corners, all in the same town and range, may be recorded on this certificate.


Description of original monument and accessories and/or subsequent restoration:

- 1837 Milny set post
- 1903 Denslow/Coburn set cedar stake at equi-distance (B.3 P.204) (L.1 P.150)
- 1968-72 MSHD Job No. 00519A Fnd. 1/2"x2" bar

Description of corner evidence found and/or method applied in restoring or reestablishing corner:

March 1997 Found 1/2"x2" bar, 13" long, 6" below grade.
Also found 2"x2" wood post next to bar
Excavated to a depth of 3 feet below grade
Found no further evidence
Measurements:
I-6 to I-5 = 2620.22' (2634.72' {39.92 chains} CSR)
I-6 to I-7 = 2629.81' (2630.11' MSHD) (2634.72' {39.92 chains} CSR)

Accepted as the best available evidence for the position of the accepted corner. Corner was approved by the Peer Review Committee on:

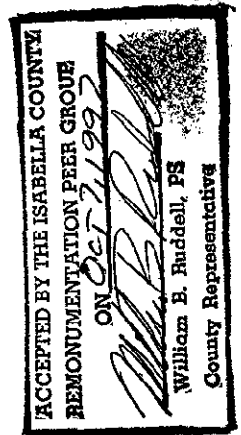

Description of monument for corner and accessories established to perpetuate locating the position of the corner:

A standard remonumentation corner was set/stamped with corner's code number (I-6) and P.S. 41917.

WITNESSES:

- N14W 64.80' Fnd. nail and tag in E. face 40" maple clump (MSHD)
- West 27.00' Fnd. nail in S. face fence post
- SSE 50.05' Set nail and cap in W. face 14" oak
- NNE 34.43' Set nail and cap in W. face 6" pine



Signed by R.R.H. Date 10/30/97
Surveyor's Michigan License No. 41917

FORM APPROVED BY MICHIGAN STATE BOARD OF LAND SURVEYORS.