

SURVEY & REMONUMENTATION

MAR 09 1998

REMONUMENTATION CORNER LAND CORNER RECORDATION CERTIFICATE Filing Requirement of Act 74, Mich. P.A. 1970

SECTION

Corners in		Located In:	Corner Code #
Isabella			
(County)			
Public Land Survey	T 14N R 6W		I-7
	T _____ R _____		_____
	T _____ R _____		_____
	T _____ R _____		_____
Property Controlling in Section	S _____ T _____ R _____		_____
Miscellaneous	S _____ T _____ R _____		_____
Property in Sec.	S _____ T _____ R _____		_____

9700125626
 Filed for Record in
 ISABELLA COUNTY, MI
 SHARON A BROWN
 On 11-07-1997 At 08:57:35 am.
 RE LAND COR 9.00
 Book OR Vol. 1 Pg. 201 - 201

Register of Deeds Stamp & File Number

Lot No. _____, Recorded Plat _____
 Private Claims _____

Ronald R. Harris in a field survey on March 26, 19 97, hereby certify that under requirements of P.A. 74, Michigan P.A. of 1970, the corner points mentioned lines 1 and 2 above were in conformance with regulations and rules therefore as required in the present manual of survey instructions of the United States Department of the Interior, Bureau of Land Management or by a decree of a Court of Law and/or that the corner points mentioned in lines 3, 4 and 5 above were in conformance with the rules of the Michigan Board of Land Surveyors or by a Decree of a Court of Law; established, re-established, monumented, re-monumented, recovered, found as expressed below:

NOTE: Not more than 2 corners, all in the same town and range, may be recorded on this certificate.

Description of original monument and accessories and/or subsequent restoration:

- 1837 Milny set post
- 1899 Denslow/Coburn fnd. stone by Coburn 1888 (L.1 P.12)
- 1900 Denslow/Coburn "see section 22" (B.3 P.155) (L.1 P.32)
- 1903 Denslow/Coburn no record (B.3 P.204) (L.1 P.150)
- 1968-72 MSHD Job No. 00519A Fnd. stone, replaced with boat spike
- 1995 Ruddell P.A.132 (L.005 P.497) Fnd. Mon. Box
- 1995 Ruddell LCRC 1304 Fnd. Mon. Box, could not open, used center

Description of corner evidence found and/or method applied in restoring or reestablishing corner:

March 1997 Found 1/2" capped MDCT pipe in Mon. Box
 Excavated to a depth of 2.7 feet, found large rock
 Found no further evidence
 Measurements:
 I-7 to H-7 = 2636.90' (2636.96' MSHD)
 I-7 to I-6 = 2629.81' (2630.11' MSHD)
 I-7 to I-8 = 2635.62' (2636.20' MSHD)
 I-7 to J-7 = 2608.30' (2608.59' MSHD)

Accepted as the best available evidence for the position of the accepted corner. Corner was approved by the Peer Review Committee on:


Description of monument for corner and accessories established to perpetuate locating the position of the corner:

A standard remonumentation corner was set/stamped with corner's code number (I-7) and P.S. 41917.

WITNESSES:

- NW 92.34' Fnd. nail and cap in P.P. (LCRC 1304)
- SSW 105.92' Fnd. nail and cap in W. face P.P. (LCRC 1304)
- SSE 110.63' Fnd. nail and cap in W. face pole (LCRC 1304)
- NNE 42.64' Back of curb at first expansion joint South of N. end
- South 18.6'+ Centerline M-20

Signed by *R.R.H.* Date 10/30/97
 Surveyor's Michigan License No. 41917

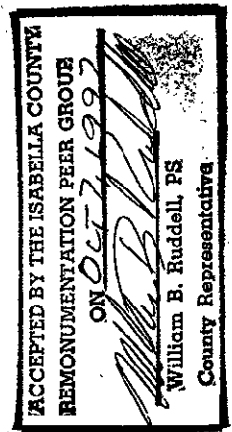

FORM APPROVED BY MICHIGAN STATE PROFESSIONAL SURVEYORS.