

SURVEY & REMONUMENTATION

MAR 09 1998

**REMONUMENTATION CORNER
LAND CORNER RECORDATION CERTIFICATE
Filing Requirement of Act 74, Mich. P.A. 1970**

SECTION

corners in
Isabella
(County)

Located In:

Corner Code #

9700125627
Filed for Record in
ISABELLA COUNTY, MI
SHARON A BROWN
On 11-07-1997 At 08:57:41 am.
RE LAND COR 9.00
Book OR Vol. 1 Pg. 202 - 202

Public Land Survey

T 14N R 6W

I-8

Property Controlling in Section

S T R

Miscellaneous Property in Sec.

S T R

Register of Deeds Stamp & File Number

Lot No. _____, Recorded Plat _____

Private Claims _____

	A	B	C	D	E	F	G	H	I	J	K	L	M
1													
2	6	5	4	3	2	1							
3													
4	7	8	9	10	11	12							
5													
6	18	17	16	15	14	13							
7													
8	19	20	21	22	23	24							
9													
10	30	29	28	27	26	25							
11													
12	31	32	33	34	35	36							
13													

Ronald R. Harris, in a field survey on March 26, 1997, hereby certify that under requirements of P.A. 74, Michigan P.A. of 1970, the corner points mentioned in lines 1 and 2 above were in conformance with regulations and rules therefore as required in the current manual of survey instructions of the United States Department of the Interior, Bureau of Land Management or by a decree of a Court of Law and/or that the corner points mentioned in lines 3, 4 and 5 above were in conformance with the rules of the Michigan Board of Land Surveyors or by a Decree of a Court of Law; established, re-established, monumented, re-monumented, recovered, found as expressed below:

NOTE: Not more than 2 corners, all in the same town and range, may be recorded on this certificate.


Description of original monument and accessories and/or subsequent restoration:

- 1837 Milny set post
- 1899 Coburn stone marked with "+" (B.3 P.134) (L.1 P.12)
- 1900 Coburn no record (B.3 P.155) (L.1 P.32)
- 1968-72 MSHD Job No. 00519A fnd. stone with "+", raised with 3/4" pipe and crockery
- 1976 Fluharty P.A.132 (L.002 P.255) fnd. 1" pipe with brass cap
- 1976 Fluharty LCRC 398 fnd. 1" pipe with brass cap
- 1980 Mueller P.A.132 (L.003 P.500) fnd. 3/4" pipe in mon. box (MSHD tag)
- 1980 Mueller P.A.132 (L.003 P.508) unknown
- 1995 Ruddell P.A.132 (L.005 P.497) fnd. 1" pipe
- 1995 Ruddell LCRC 1304 fnd. 1" pipe

Description of corner evidence found and/or method applied in restoring or reestablishing corner:

March 1997 Found 1" pipe with cap
Excavated and found crockery remains 8" below grade; found stones at 15" below grade;
Found stone with "+" 24" below grade; continued to depth of 4 feet.
Found no further evidence
Measurements:
I-8 to I-7 = 2635.62' (2636.20' MSHD)
I-8 to I-9 = 2635.05'

Accepted as the best available evidence for the position of the accepted corner, Corner was approved by the Peer Review Committee on:

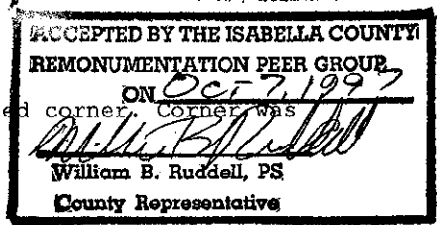


Description of monument for corner and accessories established to perpetuate locating the position of the corner:

A standard remonumentation corner was set/stamped with corner's code number (I-8) and B.P. 1327.

WITNESSES:

- East 27.05' fnd. nail and cap in S. face 10" maple (LCRC 1304)
- SE 47.65' fnd. nail and cap in SW face 14" oak (LCRC 1304)
- WSW 25.67' fnd. nail and cap in N. face 36" oak (LCRC 1304)
- SW 42.75' fnd. nail and cap in SW face 36" oak (LCRC 1304)

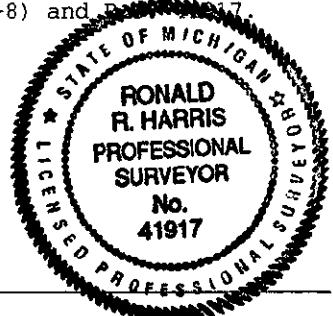

igned by ROR A

Date 10/30/97

urveyor's Michigan License No. 41917

FORM APPROVED BY MICHIGAN STATE BOARD OF LAND SURVEYORS.