

125319

LAND CORNER RECORDATION CERTIFICATE
Filing Requirement of Act 74, Mich. P.A. 1970
Isabella County Remonumentation

000179

For Corners in
Isabella

(County)

Located In: Corner Code#:

9700125319
Filed for Record in
ISABELLA COUNTY, MI
SHARON A BROWN
On 10-30-1997 At 08:40:26 am.
RE LAND COR 9.00
Book OR Vol. 1 Pg. 179 - 179

- 1. Public Land Survey T. 14N R. 6W I-10
2. Public Controlling in Section S. T. R.
3. Miscellaneous S. T. R.
4. Lot No. Recorded Plat
5. Private Claims

SURVEY &
REMONUMENTATION

NOV 07 1997

Register of Deeds Stamp & Commission



I, Jan S. Fokens, in a field survey on July 7, 1997, do hereby certify that under requirements of P.A. 74, Michigan P.A. of 1970, the corner points mentioned in lines 1 and 2 above were in conformance with regulations and rules therefore as required in the current manual of survey instructions of the United States Department of the Interior, Bureau of Land Management or by a decree of a Court of Law and/or that the corner points mentioned in lines 3, 4 and 5 above were in conformance with the rules of the Michigan Board of Land Surveyors or by a Decree of a Court of Law, established, re-established, monumented, re-monumented, recovered, found as expressed below.

NOTE: Not more than 2 corners, all in the same town and range, may be recorded on this certificate.

Grid table with columns A-M and rows 1-13. Cell (10, G) contains a star symbol.

A. Description of original monument and accessories and/or subsequent restoration:

- 1. G.L.O Original Survey Township Lines: 2nd Quarter 1837 John Hodgson Subdivision and Resurvey: 3rd Quarter 1837 John Milroy Page 586 Original Field Notes
2. County Survey Records: Liber 3 Page 139 Dated April 30-May 3, 1900 E.R. Coburn Liber 4 Page 38-39 Dated August 14-17, 1900 Grant H. Denslow Sm. Liber 1 Page 18-19 Dated May 1900 E.R. Coburn Sm. Liber 1 Page 230 Dated August 1, 1905 Grant H. Denslow
3. L.C.R.C. None found in research
4. Surveys of Record None found in research
5. Unrecorded Survey I.C.R.C. Found 3/4" pipe witnesses sited R.E.I files Found 3/4" pipe witnesses sited

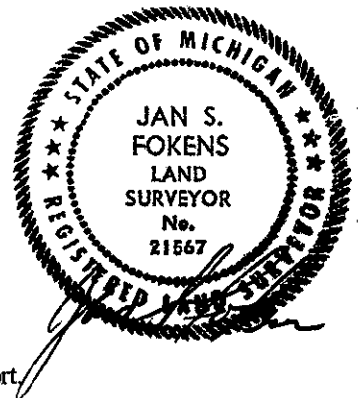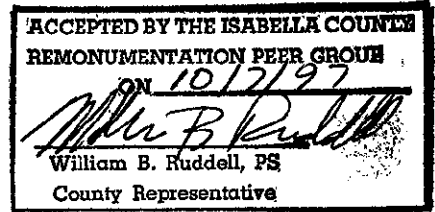

B. Description of corner evidence found and/or method applied in restoring or re-establishing corner:

- This corner established in Isabella County Remonumentation Program See dossier for detailed report.
1. Found 3/4" pipe at gravel road surface on occupied line East & West
2. Stopped excavating at 4.0'. Found no further evidence.

Accepted as best available evidence of the position of the original corner and replaced with Standard Monument Corner I-10 was approved for remonumentation at a Peer Review Committee meeting on October 7, 1997.

C. Description of monument for corner and accessories established to perpetuate locating the position of the corner:

- Set standard Isabella County Monument in Monument Box.
S88°W 28.50' Found nail & flagging in South face of 42" Maple
S88°E 24.30' Found nail & flagging in North face of 32" Maple
N27°E 69.80' Set nail & LSC tag in S.E. face of 28" Maple
S26°E 38.00' Found nail & flagging in 15" Cherry
Distance measured from I-10 South to I-11 2636.35 ft.
Distance measured from I-10 North to I-9 2644.72 ft.

Signed by Jan S. Fokens
Surveyor's Michigan License No. 21567

Date 10/23/97