

125320

LAND CORNER RECORDATION CERTIFICATE
Filing Requirement of Act 74, Mich. P.A. 1970
Isabella County Remonumentation

000180

For Corners in
Isabella

(County)

Located In:

Corner Code#:

9700125320
Filed for Record in
ISABELLA COUNTY, MI
SHARON A BROWN
On 10-30-1997 At 08:40:31 am.
RE LAND CDR 9.00
Book DR Vol. 1 Pg. 180 - 180

- 1. Public Land Survey T. 14N R. 6W L-11
2. Public Controlling in Section S. T. R.
3. Miscellaneous Property in Section S. T. R.
4. Lot No. Recorded Plat
5. Private Claims

SURVEY &
REMONUMENTATION

NOV 07 1997

Register of Deeds Stamp & File Number

COMMISSION


I, Jan S. Fokens, in a field survey on July 7, 1997, do hereby certify that under requirements of P.A. 74, Michigan P.A. of 1970, the corner points mentioned in lines 1 and 2 above were in conformance with regulations and rules therefore as required in the current manual of survey instructions of the United States Department of the Interior, Bureau of Land Management or by a decree of a Court of Law and/or that the corner points mentioned in lines 3, 4 and 5 above were in conformance with the rules of the Michigan Board of Land Surveyors or by a Decree of a Court of Law, established, re-established, monumented, re-monumented, recovered, found as expressed below.

Grid table with columns A-M and rows 1-13. A dot is present at row 11, column J.

NOTE: Not more than 2 corners, all in the same town and range, may be recorded on this certificate.

A. Description of original monument and accessories and/or subsequent restoration:

- 1. G.L.O Original Survey
Township Lines: 2nd Quarter 1837 John Hodgson
Subdivision and Resurvey: 3rd Quarter 1837 John Milroy
Page 584 Original Field Notes
2. County Survey Records:
Liber 2 Page 386-7 Dated January 2-8, 1890 E.R. Coburn
Liber 3 Page 86 Dated April 28-31, 1897 W. H. Trussell
Liber 3 Page 139 Dated April 30-May 3, 1900 E.R. Coburn
Liber 4 Page 38-9 Dated August 14-17, 1900 Grant Denslow
Sm. Liber 1 Page 18 Dated May, 1900 E.R. Coburn
Sm. Liber 1 Page 230-1 Dated August 30, 1905 Grant Denslow

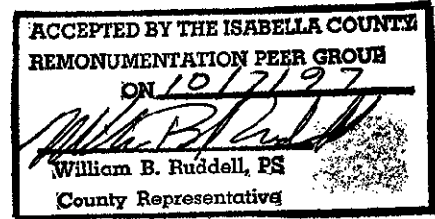


- 3. L.C.R.C.
Liber 3 Page 997 William Ruddell Recorded date: January 24, 1990 Found 1 1/4" solid shaft
4. Surveys of Record
None found in research
5. Unrecorded Survey
I.C.R.C. Section corner map Found 3/4" pipe
R.E.I files Found 1 1/4" solid shaft witnesses noted

B. Description of corner evidence found and/or method applied in restoring or re-establishing corner:
This corner established in Isabella County Remonumentation Program See dossier for detailed report.
1. Found 3/4" pipe at gravel road surface
2. Found 1 1/4" solid shaft at approximately 2.5'.
3. Stopped excavating at 5'. Found no further evidence.

Accepted as best available evidence of the position of the original corner and replaced with Standard Monument. Corner I-11 was approved for remonumentation at a Peer Review Committee meeting on October 7, 1997.

C. Description of monument for corner and accessories established to perpetuate locating the position of the corner:

- Set Standard Isabella County Monument in Monument Box.
S29°E 59.50' Top center of telephone riser
S70°W 75.20' Set nail & LSC tag in 4" Red Pine
N41°E 66.73' Set nail & LSC tag in 3.8" Red Pine
N45°W 57.25' Set nail & LSC tag in N.W. face of 11" Red Pine
N27°W 63.00' Found Ruddell nail & tag #14769 in N.E. face of 12" Red Pine
Measured from I-11 West to H-11 2615.75 ft.
Measured from I-11 East to J-11 2623.08 ft.
Measured from I-11 South to I-12 2636.76 ft.
Measured from I-11 North to I-10 2636.35 ft.

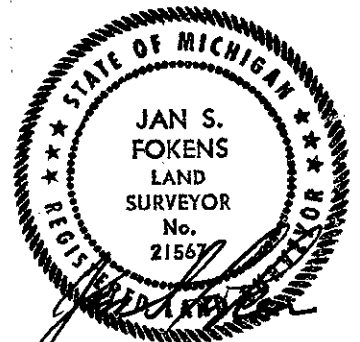

Signed by [Signature]
Surveyor's Michigan License No. 21567

Date 10/23/97