

**SURVEY &
REMONUMENTATION**

MAR 09 1998

**REMONUMENTATION CORNER
LAND CORNER RECORDATION CERTIFICATE
Filing Requirement of Act 74, Mich. P.A. 1970**

SECTION

corners in
Isabella
(County)

Located In: _____ Corner Code # _____

Public Land Survey T 14N R 6W J-7
T _____ R _____
T _____ R _____
T _____ R _____

Property Controlling S _____ T _____ R _____
in Section S _____ T _____ R _____
Miscellaneous S _____ T _____ R _____
Property in Sec. S _____ T _____ R _____

9700125628
Filed for Record in
ISABELLA COUNTY, MI
SHARON A BROWN
On 11-07-1997 At 08:57:47 am.
RE LAND COR 9.00
Book OR Vol. 1 Pg. 203 - 203

Register of Deeds Stamp & File Number

Lot No. _____, Recorded Plat _____
Private Claims _____

	A	B	C	D	E	F	G	H	I	J	K	L	M
1													
2	6	5	4	3	2	1							
3													
4	7	8	9	10	11	12							
5													
6	18	17	16	15	14	13							
7													
8	19	20	21	22	23	24							
9													
10	30	29	28	27	26	25							
11													
12	31	32	33	34	35	36							
13													

Ronald R. Harris, in a field survey on March 26, 19 97, hereby certify that under requirements of P.A. 74, Michigan P.A. of 1970, the corner points mentioned lines 1 and 2 above were in conformance with regulations and rules therefore as required in the present manual of survey instructions of the United States Department of the Interior, Bureau of Land Management or by a decree of a Court of Law and/or that the corner points mentioned in lines 3, 4 and 5 above were in conformance with the rules of the Michigan Board of Land Surveyors or by a Decree of a Court of Law; established, re-established, monumented, re-monumented, recovered, found as expressed below:

NOTE: Not more than 2 corners, all in the same town and range, may be recorded on this certificate.

Description of original monument and accessories and/or subsequent restoration:

- 1837 Milny set post
- 1900 Coburn stone (B.3 P.155) (L.1 P.32)
- 1968-72 MSHD Job No. 00519A set boat spike opposite fence to south
- 1977 Jones P.A.132 (L.002 P.639) fnd. boat spike
- 1996 Gray LCRC 1321 fnd. iron with brass cap in Mon. Box

Description of corner evidence found and/or method applied in restoring or reestablishing corner:

March 1997 Found 1/2" capped MDOT pipe in Mon. Box
Excavated to a depth of 4.3 feet
Found no further evidence, this position falls in a ditch area, approximately 20' below original ground (verified per MSHD plans).
Measurements:
J-7 to I-7 = 2608.30' (2608.59' MSHD)
J-7 to K-7 = 2609.95' (2610.15' MSHD)


Accepted as the best available evidence for the position of the accepted corner. Corner was approved by the Peer Review Committee on:

Description of monument for corner and accessories established to perpetuate locating the position of the corner:

A standard remonumentation corner was set/stamped with corner's code number (J-7) and P.S. 41917.

WITNESSES:

- N45W 209.80' Fnd. nail and tag in SW face 20" oak (LCRC 1321)
- North 98.27' Top centerline concrete R/W marker (LCRC 1321)
- South 50.26' Top centerline concrete R/W marker (LCRC 1321)
- S48E 104.16' Fnd. nail and tag in 6" pine (LCRC 1321)
- North 24.1' Centerline M-20 (LCRC 1321)

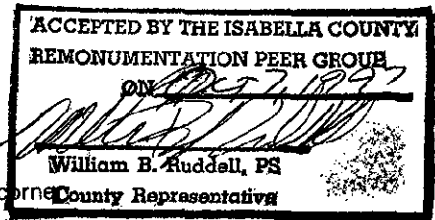

Signed by [Signature] Date 10/30/97
Surveyor's Michigan License No. 41917



FORM APPROVED BY MICHIGAN BOARD OF PROFESSIONAL SURVEYORS.