

NOV 07 1997

COMMISSION 000176

125316

LAND CORNER RECORDATION CERTIFICATE
Filing Requirement of Act 74, Mich. P.A. 1970
Isabella County Remonumentation

For Corners in Isabella (County)

Table with columns: Located In (Township, Range), Corner Code#. Rows include Public Land Survey, Public Controlling in Section, Miscellaneous Property in Section, Lot No., Private Claims.

9700125316
Filed for Record in ISABELLA COUNTY, MI
SHARON A BROWN
On 10-30-1997 At 08:40:13 am.
RE LAND COR 9.00
Book DR Vol. 1 Pg. 176 - 176

Register of Deeds Stamp & File Number


I, Jan S. Fokens, in a field survey on July 7, 1997, do hereby certify that under requirements of P.A. 74, Michigan P.A. of 1970, the corner points mentioned in lines 1 and 2 above were in conformance with regulations and rules therefore as required in the current manual of survey instructions of the United States Department of the Interior, Bureau of Land Management or by a decree of a Court of Law and/or that the corner points mentioned in lines 3, 4 and 5 above were in conformance with the rules of the Michigan Board of Land Surveyors or by a Decree of a Court of Law, established, re-established, monumented, re-monumented, recovered, found as expressed below.

NOTE: Not more than 2 corners, all in the same town and range, may be recorded on this certificate.

A. Description of original monument and accessories and/or subsequent restoration:

- G.L.O Original Survey: Township Lines: 2nd Quarter 1837 John Hodgson; Subdivision and Resurvey: 3rd Quarter 1837 John Milroy; Page 588 Original Field Notes.
County Survey Records: Liber 3 Page 155 Dated September 26-8, 1900 E.R. Coburn Set Sleigh Shoe; Liber 4 Page 38-9 Dated August 14-17, 1905 Grant Denslow; Sm. Liber 1 Page 32-3 Dated October 10, 1900 E.R. Coburn; Sm. Liber 1 Page 230-1 Dated August 30, 1905 Grant Denslow.
L.C.R.C. None found in research.
Surveys of Record None found in research.
Unrecorded Survey R.E.I. files Found 1"x3" iron bar.

Grid table with columns A-K-L-M and rows 1-13. Contains numbers 6-36 and a diamond symbol at row 9, column J.

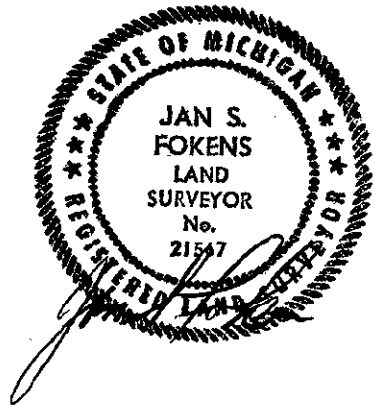


Description of corner evidence found and/or method applied in restoring or re-establishing corner:

- This corner established in Isabella County Remonumentation Program. See dossier for detailed report.
1. Found 1" x 3" x 3' long iron bar at surface of gravel road on fence line to South.
2. Large rock found along North edge of iron bar
3. Stopped excavating at 3.5'. Found no further evidence.

Accepted as best available evidence of the position of the original corner and replaced with Standard Monument Corner. J-9 was approved for monumentation at a Peer Review Committee meeting on October 7, 1997.

Description of monument for corner and accessories established to perpetuate locating the position of the corner:

- Set Standard Isabella County Monument in Monument Box.
S50°E 50.20' Set nail & LSC tag in West face of 31" Oak
S70°W 60.27' Center of pipe at N.E. corner of small cemetery
N3°E 38.55' Found nail & flagging in West face of 8" Elm
S55°W 77.00' Set nail & LSC tag in East face of double Poplar
Distance measured J-9 East to K-9 2617.13 ft.
Distance measured J-9 West to I-9 2619.32 ft.

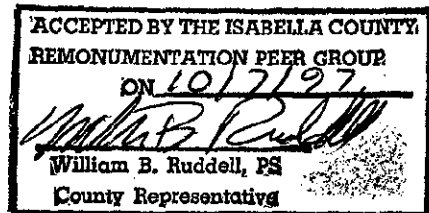

Signed by Jan S. Fokens Surveyor's Michigan License No. 21567

Date 10/23/97