

NOV 07 1997

COMMISSION  
000177

125317

**LAND CORNER RECORDATION CERTIFICATE**  
**Filing Requirement of Act 74, Mich. P.A. 1970**  
**Isabella County Remonumentation**

For Corners in  
Isabella

(County)

Located In: Corner Code#:

9700125317  
Filed for Record in  
ISABELLA COUNTY, MI  
SHARON A BROWN  
On 10-30-1997 At 08:40:17 am.  
RE LAND COR 9.00  
Book OR Vol. 1 Pg. 177 - 177

1. Public Land Survey T. 14N R. 6W Corner Code# J-11  
T. \_\_\_\_\_ R. \_\_\_\_\_  
T. \_\_\_\_\_ R. \_\_\_\_\_  
2. Public Controlling S. \_\_\_\_\_ T. \_\_\_\_\_ R. \_\_\_\_\_  
in Section S. \_\_\_\_\_ T. \_\_\_\_\_ R. \_\_\_\_\_  
3. Miscellaneous S. \_\_\_\_\_ T. \_\_\_\_\_ R. \_\_\_\_\_  
Property in Section S. \_\_\_\_\_ T. \_\_\_\_\_ R. \_\_\_\_\_  
4. Lot No. \_\_\_\_\_, Recorded Plat \_\_\_\_\_  
5. Private Claims \_\_\_\_\_

Register of Deeds Stamp & File Number

I, Jan S. Fokens, in a field survey on July 7, 1997, do hereby certify that under requirements of P.A. 74, Michigan P.A. of 1970, the corner points mentioned in lines 1 and 2 above were in conformance with regulations and rules therefore as required in the current manual of survey instructions of the United States Department of the Interior, Bureau of Land Management or by a decree of a Court of Law and/or that the corner points mentioned in lines 3, 4 and 5 above were in conformance with the rules of the Michigan Board of Land Surveyors or by a Decree of a Court of Law, established, re-established, monumented, re-monumented, recovered, found as expressed below.

	A	B	C	D	E	F	G	H	I	J	K	L	M
1													
2	6	5	4	3	2	1							
3													
4	7	8	9	10	11	12							
5													
6	18	17	16	15	14	13							
7													
8	19	20	21	22	23	24							
9													
10	30	29	28	27	26	25							
11													
12	31	32	33	34	35	36							
13													

NOTE: Not more than 2 corners, all in the same town and range, may be recorded on this certificate.

A. Description of original monument and accessories and/or subsequent restoration:

1. G.L.O Original Survey  
Township Lines: 2nd Quarter 1837 John Hodgson  
Subdivision and Resurvey: 3rd Quarter 1837 John Milroy  
Page 586 Original Field Notes
2. County Survey Records:  
Liber 3 Page 86 Dated April 28-31, 1897 W.H. Trussell  
Liber 4 Page 38-9 Dated August 14-17, 1900 Grant Denslow  
Sm. Liber 1 Page 230-1 Dated August 30, 1905 Grant Denslow

3. L.C.R.C.  
None found in research
4. Surveys of Record  
None found in research
5. Unrecorded Survey  
P.B.L. & A Certificate of Survey



B. Description of corner evidence found and/or method applied in restoring or re-establishing corner:  
This corner established in Isabella County Remonumentation Program. See dossier for detailed report

1. Found Gerald Gray capped iron at gravel road surface
2. Stopped excavating at 3'. Found no further evidence.

Accepted as best available evidence of the position of the original corner and replaced with Standard Monument Corner. J-11 was approved for remonumentation at a Peer Review Committee meeting on July 29, 1997.

C. Description of monument for corner and accessories established to perpetuate locating the position of the corner:

Set Standard Isabella County Monument in Monument Box.  
S12°W 61.30' Found nail in West face of a very large multiple Beech  
S17°E 41.87' Found nail in East face of 7" Cherry  
N50°E 27.90' Found nail & flagging in S.E. face of 19" Oak  
N8°E 29.92' Found nail in East face of 7" Maple  
Occupied Fence Line North and South.  
Measured by Trussell to SW corner of Section 27, 1897, 2,626.97 ft.  
Measured by L.S.C to SW corner of Section 27, 1997, 2623.08 ft.

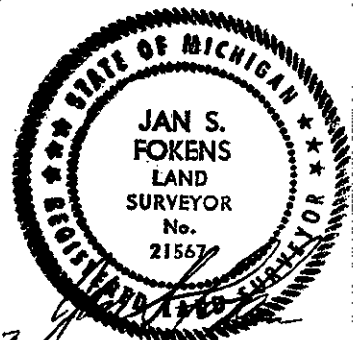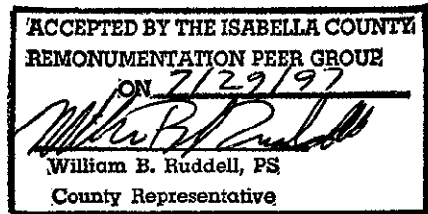

Signed by Jan S. Fokens  
Surveyor's Michigan License No. 21567

Date 10/23/97