

125322

LAND CORNER RECORDATION CERTIFICATE
Filing Requirement of Act 74, Mich. P.A. 1970
Isabella County Remonumentation

000182

For Corners in
Isabella

(County)

Located In: Corner Code#:

Filed for Record in
ISABELLA COUNTY, MI
SHARON A BROWN
On 10-30-1997 At 08:40:40 am.
RE LAND COR 9.00
Book OR Vol. 1 Pg. 182 - 182

SURVEY &
REMONUMENTATION

NOV 07 1997

COMMISSION

Register of Deeds Stamp & File Number

- 1. Public Land Survey T. 14N R. 6W K-10
2. Public Controlling in Section S. T. R.
3. Miscellaneous Property in Section S. T. R.
4. Lot No. Recorded Plat
5. Private Claims



I, Jan S. Fokens, in a field survey on July 7, 1997, do hereby certify that under requirements of P.A. 74, Michigan P.A. of 1970, the corner points mentioned in lines 1 and 2 above were in conformance with regulations and rules therefore as required in the current manual of survey instructions of the United States Department of the Interior, Bureau of Land Management or by a decree of a Court of Law and/or that the corner points mentioned in lines 3, 4 and 5 above were in conformance with the rules of the Michigan Board of Land Surveyors or by a Decree of a Court of Law, established, re-established, re-monumented, re-monumented, recovered, found as expressed below.

Grid table with columns A-M and rows 1-13. Cell (10, 26) contains a dot.

NOTE: Not more than 2 corners, all in the same town and range, may be recorded on this certificate.

A. Description of original monument and accessories and/or subsequent restoration:

- 1. G.L.O Original Survey Township Lines: 2nd Quarter 1837 John Hodgson Subdivision and Resurvey: 3rd Quarter 1837 John Milroy Page 574, 576 Original Field Notes
2. County Survey Records: Liber 3 Page 175 April 4, 1902 E.R. Coburn Liber 4 Page 38-39 August 14-17, 1900 Grant Denslow Sm. Liber 1 Page 82-83 April 25, 1902 E.R. Coburn Sm. Liber 1 Page 230-231 August 30, 1905 Grant Denslow
3. L.C.R.C. Liber 2 Page 731 Thomas Mueller Recorded Date August 23, 1984 Liber 4 Page 1177 Gerald Gray Recorded Date June 10, 1992 Found 1/2" rod in centerline of Coldwater rd.
4. Surveys of Record None found in research
5. Unrecorded Survey R.E.I. files witness sheet

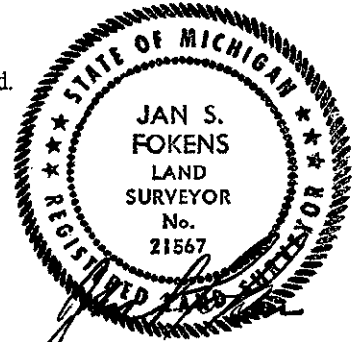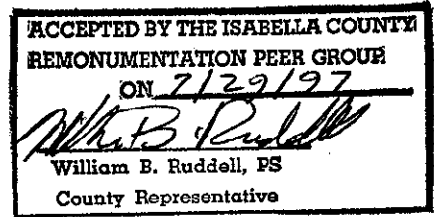

B. Description of corner evidence found and/or method applied in restoring or re-establishing corner:
This corner established in Isabella County Remonumentation Program. See dossier for detailed report.
1. Found 5/8" x 18" iron rod at surface of road
2. Stopped excavating at 3.0'. Found no further evidence.

Accepted as best available evidence of the position of the original corner and replaced with Standard Monument Corner. K-10 was approved for remonumentation at a Peer Review Committee meeting on July 29, 1997.

C. Description of monument for corner and accessories established to perpetuate locating the position of the corner:
Set Standard Isabella County Monument in Monument Box.
S50°W 72.30' Found nail & flag in N. face of 12" Oak
West 55.35' Set L.S.C. nail & tag in N. face of 14" Oak
N60°W 61.60' Found nail & flag in S. face of 12" twin Oaks
East 33.00' Found T. Mueller iron

Signed by [Signature]
Surveyor's Michigan License No. 21567

Date 10/23/97