

NOV 07 1997

COMMISSION 000185

125325

LAND CORNER RECORDATION CERTIFICATE
Filing Requirement of Act 74, Mich. P.A. 1970
Isabella County Remonumentation

For Corners in Isabella (County)

- 1. Public Land Survey Located In: T. 14N R. 6W Corner Code#: K-13
2. Public Controlling in Section
3. Miscellaneous Property in Section
4. Lot No., Recorded Plat
5. Private Claims

9700125325
Filed for Record in ISABELLA COUNTY, MI
SHARON A BROWN
On 10-30-1997 At 08:40:53 am.
RE LAND COR 9.00
Book OR Vol. 1 Pg. 185 - 185

Register of Deeds Stamp & File Number


I, Jan S. Fokens, in a field survey on July 7, 1997, do hereby certify that under requirements of P.A. 74, Michigan P.A. of 1970, the corner points mentioned in lines 1 and 2 above were in conformance with regulations and rules therefore as required in the current manual of survey instructions of the United States Department of the Interior, Bureau of Land Management or by a decree of a Court of Law and/or that the corner points mentioned in lines 3, 4 and 5 above were in conformance with the rules of the Michigan Board of Land Surveyors or by a Decree of a Court of Law, established, re-established, monumented, re-monumented, recovered, found as expressed below.

Grid table with columns A-M and rows 1-13. Contains numbers 6-36.


NOTE: Not more than 2 corners, all in the same town and range, may be recorded on this certificate.

A. Description of original monument and accessories and/or subsequent restoration:

- 1. G.L.O Original Survey Township Lines: 2nd Quarter 1837 John Hodgson Subdivision and Resurvey: 3rd Quarter 1837 John Milroy Page 550 Original Field Notes
2. County Survey Records: Liber 3 Page 86 April 28-31, 1897 W.H. Trussell Liber 3 Page 168 January 1902 W.H. Trussell Sm. Liber 1 Page 72-73 January 29, 1902 E.R. Coburn
3. L.C.R.C. Liber 3 Page 833 J.S. Fokens Recorded Date November, 1986 Liber 4 Page 1253 Gerald Gray Recorded Date July 20, 1994
4. Surveys of Record Liber 4 Page 290 Found T-iron Liber 4 Page 594 Set P.K. nail using prior witnesses
5. Unrecorded Survey I.C.R.C. Section Corner Map nothing found witnesses sited I.C.R.C. Coldwater Rd. between Milbrook & M20 Rd. plans witnesses sited R.E.I. files Found T-Iron witnesses sited L.S.C. field notes Found T-iron R.E.I. Boundry Survey Set T-iron witnesses cited R.E.I. Boundry Survey Set P.K. nail @ prior witnesses

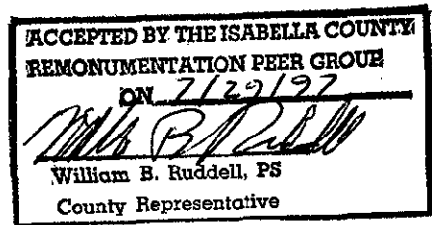

Found T-iron
Found P.K. nail in pavement

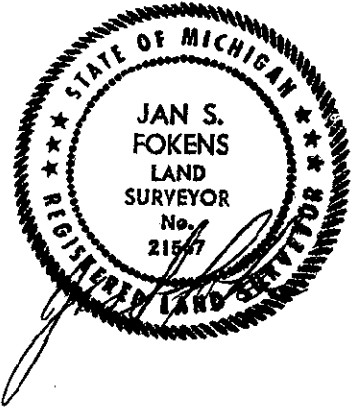

- 3. Description of corner evidence found and/or method applied in restoring or re-establishing corner: This corner established in Isabella County Remonumentation Program. See dossier for detailed report.
1. Found P.K. nail at pavement surface
2. Found T-iron below pavement surface
3. Stopped excavating at 3.0'. Found no further evidence.

Accepted as best available evidence of the position of the original corner and replaced with Standard Monument Corner. K-13 was approved for monumentation at a Peer Review Committee meeting on July 29, 1997.

2. Description of monument for corner and accessories established to perpetuate locating the position of the corner:

- Set Standard Isabella County Monument in Monument Box.
N30°E 45.50' Found Nail & Tag in W. face of P.P.
S15°W 40.75' Found Nail & Tag in 18" Spruce
N55°E 61.25' Set Nail & Tag in N.W. face of 6" White Pine
S40°W 57.20' Set Nail & Tag in W. face of 22" Spruce
N85°W 88.44' Found T-iron N.E. Corner, Sec. 2 (K-1) T13N-R6W

igned by [Signature] Surveyor's Michigan License No. 21567

Date 10/23/97