

SURVEY & REMONUMENTATION

MAR 09 1998

**REMONUMENTATION CORNER
LAND CORNER RECORDATION CERTIFICATE
Filing Requirement of Act 74, Mich. P.A. 1970**

SECTION

9700125629
Filed for Record in
ISABELLA COUNTY, MI
SHARON A BROWN
On 11-07-1997 At 08:57:52 am.
RE LAND COR 9.00
Book DR Vol. 1 Pg. 204 - 204

Register of Deeds Stamp & File Number

| | | |
|--|-------------|---------------|
| or corners in <u>Isabella</u> (County) | Located in: | Corner Code # |
| Public Land Survey | T 14N R 6W | L-7 |
| | T R | |
| | T R | |
| | T R | |
| Property Controlling in Section | S T R | |
| | S T R | |
| Miscellaneous Property in Sec. | S T R | |
| | S T R | |

Lot No. _____, Recorded Plat _____
Private Claims _____

| | | | | | | | | | | | | | |
|----|----|----|----|----|----|----|---|---|---|---|---|---|---|
| | A | B | C | D | E | F | G | H | I | J | K | L | M |
| 1 | | | | | | | | | | | | | |
| 2 | 6 | 5 | 4 | 3 | 2 | 1 | | | | | | | |
| 3 | | | | | | | | | | | | | |
| 4 | 7 | 8 | 9 | 10 | 11 | 12 | | | | | | | |
| 5 | | | | | | | | | | | | | |
| 6 | 18 | 17 | 16 | 15 | 14 | 13 | | | | | | | |
| 7 | | | | | | | | | | | | | |
| 8 | 19 | 20 | 21 | 22 | 23 | 24 | | | | | | | |
| 9 | | | | | | | | | | | | | |
| 10 | 30 | 29 | 28 | 27 | 26 | 25 | | | | | | | |
| 11 | | | | | | | | | | | | | |
| 12 | 31 | 32 | 33 | 34 | 35 | 36 | | | | | | | |
| 13 | | | | | | | | | | | | | |

Ronald R. Harris, in a field survey on March 26, 1997, hereby certify that under requirements of P.A. 74, Michigan P.A. of 1970, the corner points mentioned in lines 1 and 2 above were in conformance with regulations and rules therefore, as required in the current manual of survey instructions of the United States Department of the Interior, Bureau of Land Management or by a decree of a Court of Law and/or that the corner points mentioned in lines 3, 4 and 5 above were in conformance with the rules of the Michigan Board of Land Surveyors or by a Decree of a Court of Law; established, re-established, monumented, re-monumented, recovered, found as expressed below:

NOTE: Not more than 2 corners, all in the same town and range, may be recorded on this certificate.

Description of original monument and accessories and/or subsequent restoration:

- 1837 Milny set post
- 1902 Coburn stake (B.3 P.186) (L.1 P.108)
- 1968-72 MSHD Job No. 00519A set axle shaft
- 1973 Radcliffe P.A.132 (L.001 Pgs.470-472) no record of object
- 1979 Ruddell P.A.132 (L.003 P.467) fnd. axle shaft
- 1989 Ruddell unrecorded survey fnd. axle shaft

Description of corner evidence found and/or method applied in restoring or reestablishing corner:

March 1997 Found 1/2" capped MDOT pipe in Mon. Box
Excavated to a depth of 3 feet
Found no further evidence
corner approximately 15 feet below original ground
Measurements:
L-7 to K-7 = 2655.42' 555.50' MSHD)
L-7 to M-7 = 2640.07' 640.63' MSHD)

Accepted as the best available evidence for the position of the corner. Corner was approved by the Peer Review Committee on:


Description of monument for corner and accessories established to perpetuate locating the position of the corner:

A standard remonumentation corner was set/stamped with corner's code number (L-7) and P.S. 41917.

WITNESSES:

- ESE 54.44' Set nail and cap in N. face 3" pine
- South 19.83' Top centerline concrete R/W marker
- N02W 110.04' East edge sign post "MOTORIZED VEHICLE PROHIBITED"
- North 128.29' Top centerline concrete R/W marker
- North 54.0'± Centerline M-20

Witnessed by ROR A. Date 10/30/97
Surveyor's Michigan License No. 41917

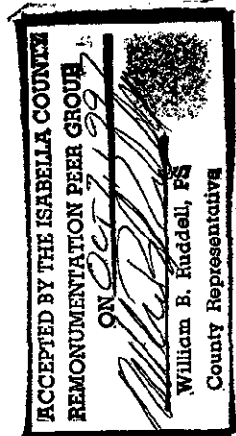

FORM APPROVED BY MICHIGAN STATE BOARD OF PROFESSIONAL SURVEYORS.