

12919

JAN 25 2000

REMONUMENTATION CORNER SECTION
LAND CORNER RECORDATION CERTIFICATE
Filing Requirement of Act 74, Mich. P.A. 1970

000347

For corners in

Isabella (County) Located In: Corner Code #
1. Public Land Survey T 14N R 6W L-13
2. Property Controlling in Section S T R
3. Miscellaneous Property in Sec. S T R

199900012919
Filed for Record in
ISABELLA COUNTY, MI
SHARON A BROWN
On 12-29-1999 At 09:36:35 am.
RE LAND COR 9.00
Liber 1 Page 347 - 347

Register of Deeds Stamp & File Number

- 4. Lot No. Recorded Plat
5. Private Claims

I, Ronald R. Harris, P.S., in a field survey on November 24, 19 99, do hereby certify that under requirements of P.A. 74, Michigan P.A. of 1970, the corner points mentioned in lines 1 and 2 above were in conformance with regulations and rules therefore as required in the current manual of survey instructions of the United States Department of the Interior, Bureau of Land Management or by a decree of a Court of Law and/or that the corner points mentioned in lines 3, 4 and 5 above were in conformance with the rules of the Michigan Board of Land Surveyors or by a Decree of a Court of Law; established, re-established, monumented, re-monumented, recovered, found as expressed below:

Table with 13 rows and 12 columns (A-M) containing numbers 1-36 in a grid pattern.

NOTE: Not more than 2 corners, all in the same town and range, may be recorded on this certificate.

A. Description of original monument and accessories and/or subsequent restoration:

- 1837 Milny GLO.....set quarter section post
1902 Coburn/Trussell C.S.....set stone marked 'X', equidistant from I to N, on correction line
1974 William B. Ruddell P.A. 132...set 3/4" pipe
1986 Jan S. Fokens P.A. 132.....found 3/4" pipe
1989 William B. Ruddell P.A. 132...set spike at prior witnesses
1993 Gerald J. Gray LCRC.....found nail, reset with bar and cap
1994 Gerald J. Gray LCRC.....found nail, reset with 1/2X18" bar and cap
1997 Ronald R. Harris.....found capped iron
1999 Ronald R. Harris P.A. 132....found iron rod
1999 Ronald R. Harris P.A. 132....found iron rod

B. Description of corner evidence found and/or method applied in restoring or reestablishing corner:

November 1999: Found Capped iron (# 17741) 6" below road grade. Found 3/4" pipe 2' deep below capped iron. Excavated to depth of 4', found no other evidence of corner
This is an existent corner.


C. Description of monument for corner and accessories established to perpetuate locating the position of the corner:

A Remonumentation monument stamped #41917, placed inside a monument box, was set at the position of the found capped iron and is accepted as the best available evidence of the perpetuated corner.

WITNESSES

- West 47.10' Found Capped iron, North 1/4 corner, section 1, T13N-R6W, Rolland Township.
SSE 38.66' Found Nail and Flagging in 8" Poplar.
SSW 63.67' Found Nail and Flagging in 8" tree.
North 33.00' Found 'T' iron at Right-of-Way.

Distances:
L-13 to M-13.....2640.35'
L-13 to K-13.....2641.46'

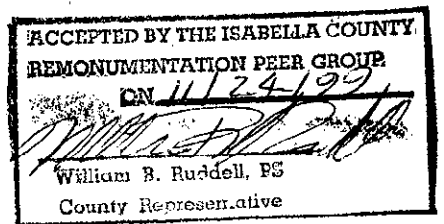

Signed by [Signature]
Surveyor's Michigan License No. 41917

Date 12/02/99