

APR 29 1996

LAND CORNER RECORDATION CERTIFICATE  
Filing Requirement of Act 74, Mich. P.A. 1970  
Isabella County Remonumentation

COMMISSION

For Corners in  
Isabella

(County)	Located In:	Corner Code#:
1. Public Land Survey	T. <u>15 N.</u> R. <u>3 W.</u>	<u>E-10</u>
	T. _____ R. _____	_____
	T. _____ R. _____	_____
2. Public Controlling in Section	S. _____ T. _____ R. _____	_____
	S. _____ T. _____ R. _____	_____
3. Miscellaneous Property in Section	S. _____ T. _____ R. _____	_____
	S. _____ T. _____ R. _____	_____
4. Lot No. _____, Recorded Plat _____		
5. Private Claims _____		

STATE OF MICHIGAN  
COUNTY OF ISABELLA  
RECEIVED FOR RECORD

Nov 30 3 34 PM '95  
000066

SHARON A. BROWN  
REGISTER OF DEEDS

Register of Deeds Stamp & File Number

I, Jan S. Fokens, in a field survey on August, 1995, do hereby state that under requirements of P.A. 74, Michigan P.A. of 1970, the corner points mentioned in lines 1 and 2 above were in conformance with regulations and rules therefore as required in the current manual of survey instructions of the United States Department of the Interior, Bureau of Land Management or by a decree of a Court of Law and/or that the corner points mentioned in lines 3, 4 and 5 above were in conformance with the rules of the Michigan Board of Professional Surveyors or by a Decree of a Court of Law, established, re-established, monumented, recovered, found as expressed below.

NOTE: Not more than 2 corners, all in the same town and range, may be recorded on this certificate.

A. Description of original monument and accessories and/or subsequent restoration:

- Original G.L.O. Survey:  
Township lines:  
South Boundary June 1831 by Robert Clark  
East Boundary November 1831 by Harvey Parke  
North Boundary May 1837 by John Hodgson  
South Boundary April 1837 by John Hodgson  
Subdivision & Re-survey July 1850 by William A. Burt  
Page 70 original field notes
- Subsequent Survey of Record by County Surveyor N. R. Arnold  
Book 1 dated 12/5/1871 (Section 28)
- No L.C.R.C
- Survey of Record, Liber 2, Page 105
- Unrecorded surveys  
Certified Survey by Land Surveying Consultants 11/1/94 Set 1/2" Re-Rod.

	A	B	C	D	E	F	G	H	I	J	K	L	M
1													
2	6	5	4	3	2	1							
3													
4	7	8	9	10	11	12							
5													
6	18	17	16	15	14	13							
7													
8	19	20	21	22	23	24							
9													
10	30	29	28	27	26	25							
11													
12	31	32	33	34	35	36							
13													

ACCEPTED BY THE ISABELLA COUNTY  
REMONUMENTATION PEER GROUP  
ON 10/17/95  
William B. Huddell, PS  
County Representative

B. Description of corner evidence found and/or method applied in restoring or re-establishing corner


In a field survey on October 31, 1994, excavated and searched for corner location.

- Found no evidence of corner.
- Excavated road 2' North & South by 4' East & West, found no evidence of corner.
- Set corner on old East-West fence line and on line between the NW corner and SW corner of Section 28, T15N- R3W  
This corner established in Isabella County Remonumentation Program. See dossier for detailed report.

C. Description of monument for corner and accessories established to perpetuate locating the position of the corner:

Set Standard Isabella County Monument in Monument Box.  
N.40°E., 71.58', LSC nail and tag in West face of 30" Red oak tree  
S.89°E., 33.00', 1/2" LSC iron  
N.59°W., 78.33', LSC nail and tag in NE. face of power pole  
S.60°W., 63.07', Top point on South side of large rock

E.10 to E.9 - 2642.90'  
E.10 to E.11 - 2648.85'

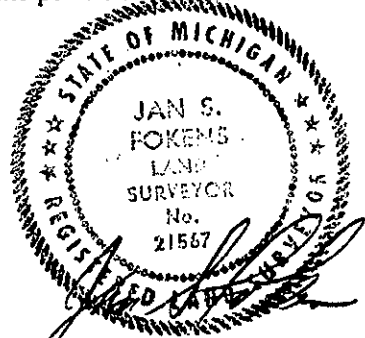

Signed by Jan S. Fokens  
Surveyor's Michigan License No. 21567

Date Nov. 17, 1995