

**SURVEY &  
REMONUMENTATION**

APR 29 1996

1053.17

**LAND CORNER RECORDATION CERTIFICATE**  
Filing Requirement of Act 74, Mich. P.A. 1970  
Isabella County Remonumentation

COMMISSION

STATE OF MICHIGAN  
COUNTY OF ISABELLA  
RECEIVED RECORD

Nov 30 3 34 PM '95  
000068  
SHARON A. BROWN  
REGISTER OF DEEDS

Register of Deeds Stamp & File Number

For Corners in  
Isabella

(County)	Located In:	Corner Code#:
1. Public Land Survey	T. <u>15 N.</u> R. <u>3 W.</u>	<u>F-9</u>
	T. _____ R. _____	_____
	T. _____ R. _____	_____
2. Public Controlling in Section	S. _____ T. _____ R. _____	_____
	S. _____ T. _____ R. _____	_____
3. Miscellaneous Property in Section	S. _____ T. _____ R. _____	_____
	S. _____ T. _____ R. _____	_____
4. Lot No. _____, Recorded Plat		
5. Private Claims		

I, Jan S. Fokens, in a field survey on August, 1995, do hereby state that under requirements of P.A. 74, Michigan P.A. of 1970, the corner points mentioned in lines 1 and 2 above were in conformance with regulations and rules therefore as required in the current manual of survey instructions of the United States Department of the Interior, Bureau of Land Management or by a decree of a Court of Law and/or that the corner points mentioned in lines 3, 4 and 5 above were in conformance with the rules of the Michigan Board of Professional Surveyors or by a Decree of a Court of Law, established, re-established, monumented, recovered, found as expressed below.

**NOTE: Not more than 2 corners, all in the same town and range, may be recorded on this certificate.**

A. Description of original monument and accessories and/or subsequent restoration:

1. Original G.L.O. Survey:

Township lines:

South Boundary June 1831 by Robert Clark

East Boundary Nov. 1831 by Harvey Parke

North Boundary May 1837 by John Hodgson

West Boundary April 1837 by John Hodgson

Subdivision & Re-survey 3rd quarter 1850 by Wm. A. Burt;

Page 68 original field notes

2. Subsequent survey of record by County Surveyor N.R. Arnold;

Book 1 Dated 12/5/1871 (Section 28)

3. L.C.R.C.

Liber 2, Page 572, P. Lapham 9/5/79

Isabella County Road Commission

Found 1/2" pipe

Found 1/2" pipe

4.No survey of record.

5.Unrecorded survey, Certified Survey by Land Survey by Land Surveying Consultants 11/01/94, found 3/4" pipe.

B. Description of corner evidence found and/or method applied in restoring or re-establishing corner:

In a field survey on August 22, 1995, excavated and searched for the corner location:

1. Found 3/4" dia. pipe, top of pipe 0.3' below surface of gravel road.

2. Excavated trench 2' wide by 7' long to depth of 2'; found no further evidence of corner.

This corner established in Isabella County Remonumentation Program. See dossier for detailed report.

C. Description of monument for corner and accessories established to perpetuate locating the position of the corner:

Set Standard Isabella County Monument in Monument Box.

N.05°E., 33.10', 1/2" P. Lapham iron

N.36°E., 44.20'. nail in South face of 6" ash tree (old wit.)

N.73°E., 90.58', LSC Nail and tag in SW face of 5" ash tree


S.55°E., 128.60', LSC Nail and tag in North face of power pole

F.9 to G.9 - 2659.05'

F.9 to E.9 - 2655.96'

1	A	B	C	D	E	F	G	H	I	J	K	L	M
2	6	5	4	3	2	1							
3													
4	7	8	9	10	11	12							
5													
6	18	17	16	15	14	13							
7													
8	19	20	21	22	23	24							
9													
10	30	29	28	27	26	25							
11													
12	31	32	33	34	35	36							
13													

ACCEPTED BY THE ISABELLA COUNTY  
REMONUMENTATION PEER GROUP.  
ON 11/17/95  
*[Signature]*  
William B. Ruddle, PS  
County Representative

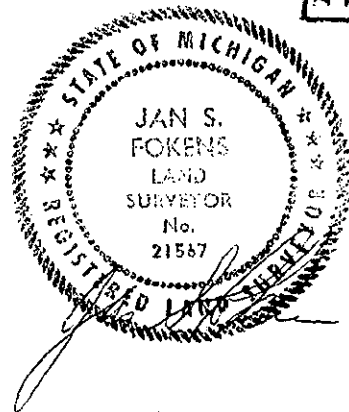

Signed by *[Signature]*  
Surveyor's Michigan License No. 21567

Date NOV. 17, 1995