

LAND CORNER RECORDATION CERTIFICATE
Filing Requirement of Act 74, Mich. P.A. 1970
Isabella County Remonumentation

JAN 25 2000

For Corners in
Isabella

(County)

Located In: Corner Code#:

- | | | |
|---------------------------------------|----------------------------|-------------|
| 1. Public Land Survey | T. <u>15N</u> R. <u>3W</u> | <u>F-13</u> |
| | T. _____ R. _____ | _____ |
| | T. _____ R. _____ | _____ |
| 2. Public Controlling in Section | S. _____ T. _____ R. _____ | _____ |
| | S. _____ T. _____ R. _____ | _____ |
| 3. Miscellaneous Property in Section | S. _____ T. _____ R. _____ | _____ |
| | S. _____ T. _____ R. _____ | _____ |
| 4. Lot No. _____, Recorded Plat _____ | | |
| 5. Private Claims _____ | | |

199900012552
 Filed for Record in SECTION
 ISABELLA COUNTY, MI
 SHARON A BROWN
 On 12-16-1999 At 08:35:02 am.
 RE LAND COR 9.00
 Liber 1 Page 331 - 331

Register of Deeds Stamp & File Number


I, Jan S. Fokens, in a field survey on June 2, 1999, do hereby certify that under requirements of P.A. 74, Michigan P.A. of 1970, the corner points mentioned in lines 1 and 2 above were in conformance with regulations and rules therefore as required in the current manual of survey instructions of the United States Department of the Interior, Bureau of Land Management or by a decree of a Court of Law and/or that the corner points mentioned in lines 3, 4 and 5 above were in conformance with the rules of the Michigan Board of Land Surveyors or by a Decree of a Court of Law, established, re-established, monumented, re-monumented, recovered, found as expressed below.

NOTE: Not more than 2 corners, all in the same town and range, may be recorded on this certificate.

	A	B	C	D	E	F	G	H	I	J	K	L	M
1													
2	6	5	4	3	2	1							
3													
4	7	8	9	10	11	12							
5													
6	18	17	16	15	14	13							
7													
8	19	20	21	22	23	24							
9													
10	30	29	28	27	26	25							
11													
12	31	32	33	34	35	36							
13													

A. Description of original monument and accessories and/or subsequent restoration:

- G.L.O Original Survey:
 Township: Robert Clark Jr. 2nd Quarter 1831
 Pages 4,6 original field notes
- County Survey Records:
 Liber 4, Page 75 William Trussell March 1909
- L.C.R.C.:
 Liber 1, Page 146 A.V. Courtright Recorded date July 16, 1973 Set 5/8" x 18" rod equidistant and on line
 Liber 2, Page 615 Paul B. Lapham Recorded date October 23, 1980 Found iron
 Liber 4, Page 1162 Gerald Gray Recorded date June 10, 1992 Found 5/8" rod
- Surveys of Record:
 Liber 1, Page 214 Found 5/8" steel rod
 Liber 1, Page 599 Distances noted
 Liber 2, Page 476 Found 5/8" re-rod
 Liber 3, Page 639 Found re-rod
 Liber 4, Page 423 Found re-rod
 Liber 5, Page 108 Found 5/8" re-bar
- Unrecorded Survey:
 Isabella County Road Commission Field notes 1992 Found 5/8" rod

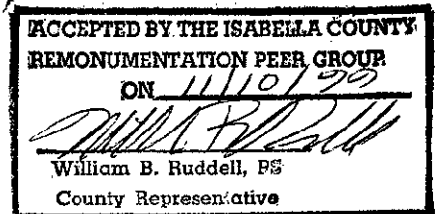

B. Description of corner evidence found and/or method applied in restoring or re-establishing corner:

- This corner established in Isabella County Remonumentation Program. See dossier for detailed report.
 This is an existent corner.
- Found 5/8" x 18" rod 0.1' below surface
 - Found wood fragments 2.0' below surface adjacent to rod
 - Excavated to 2.5'. Found no further evidence

Accepted as the best available evidence of the position of the original corner and replaced with Standard Monument Corner.

C. Description of monument for corner and accessories established to perpetuate locating the position of the corner:
 Set Standard Isabella County Monument in Monument Box, stamped F-13 and PS 21567.

- F-13 S. 1/4 Corner, Section 33, T.15N.-R.3W., Denver Township, Isabella County**
 N.37°E. 50.73' Found nail w/tag in east face in Maple
 N.63°E. 56.60' Top center of westerly cable riser
 S.10°W. 81.89' NW corner of House (8520 Baseline)
 West 52.35' (F-1) N. 1/4, Sec. 4, T14N-R3W, Chippewa Twp., Isabella Co., Michigan
 N.89°53'30"E. 2635.07' (G-13) SE. corner, Section 33, T.15N.-R.3W., Denver Twp., Isabella Co., MI
 S.89°53'23"W. 2635.16' (E-13) SW. corner, Section 33, T.15N.-R.3W., Denver Twp., Isabella Co., MI

Signed by Jan S. Fokens Date 12/14/99
 Surveyor's Michigan License No. 21567

