

LAND CORNER RECORDATION CERTIFICATE
Filing Requirement of Act 74, Mich. P.A. 1970
Isabella County Remonumentation

JAN 25 2000

For Corners in
Isabella

(County) Located In: Corner Code#:

1. Public Land Survey T. 15N R. 3W H-13
 T. _____ R. _____
 T. _____ R. _____

2. Public Controlling S. _____ T. _____ R. _____
 in Section S. _____ T. _____ R. _____

3. Miscellaneous S. _____ T. _____ R. _____
 Property in Section S. _____ T. _____ R. _____

4. Lot No. _____, Recorded Plat _____

5. Private Claims _____

199900012554 SECTION
 Filed for Record in
 ISABELLA COUNTY, MI
 SHARON A BROWN
 On 12-16-1999 At 08:35:08 am.
 RE LAND COR 9.00
 Liber 1 Page 333 - 333

Register of Deeds Stamp & File Number


I, Jan S. Fokens, in a field survey on June 10, 1999, do hereby certify that under requirements of P.A. 74, Michigan P.A. of 1970, the corner points mentioned in lines 1 and 2 above were in conformance with regulations and rules therefore as required in the current manual of survey instructions of the United States Department of the Interior, Bureau of Land Management or by a decree of a Court of Law and/or that the corner points mentioned in lines 3, 4 and 5 above were in conformance with the rules of the Michigan Board of Land Surveyors or by a Decree of a Court of Law, established, re-established, monumented, re-monumented, recovered, found as expressed below.

NOTE: Not more than 2 corners, all in the same town and range, may be recorded on this certificate.

	A	B	C	D	E	F	G	H	I	J	K	L	M
2	6	5	4	3	2	1							
3													
4	7	8	9	10	11	12							
5													
6	18	17	16	15	14	13							
7													
8	19	20	21	22	23	24							
9													
10	30	29	28	27	26	25							
11													
12	31	32	33	34	35	36							
13													

A. Description of original monument and accessories and/or subsequent restoration:

- G.L.O Original Survey:
 Township: Robert Clark Jr. 2nd Quarter 1831
 Page 4,6 original field notes
- County Survey Records:
 None of Record
- L.C.R.C.:
 None of record
- Surveys of Record:
 None of record
- Unrecorded Survey:
 Isabella County Road Commission 7/15/97 Witness notes
 Duane F. Wood 10/21/81 Certificate of Survey Distances noted

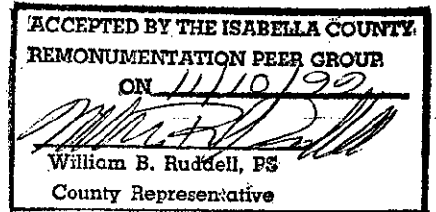

B. Description of corner evidence found and/or method applied in restoring or re-establishing corner:
 This corner established in Isabella County Remonumentation Program. See dossier for detailed report.
 This is an existent corner.
 1. Found capped iron #17741
 2. Excavated to 2.5'. Found no further evidence

Accepted as the best available evidence of the position of the original corner and replaced with Standard Monument Corner.

C. Description of monument for corner and accessories established to perpetuate locating the position of the corner:
 Set Standard Isabella County Monument in Monument Box, stamped H-13 and PS 21567.

H-13 S. 1/4 Corner, Section 34, T.15N.-R.3W., Denver Township, Isabella County
 N.53°E. 39.80' Found Mid Michigan Nail & Cap in SE face of 8" Ash
 N.11°E. 51.36' Found Nail & flagging in east face of power pole
 S.89°W. 58.50' North face mailbox post (#9571)
 S.37°E. 35.10' Set Notch in top center end of 6' corrugated metal pipe-west end
 North 33.25' Found capped iron (property corner)
 West 25.99' (H-1) N. 1/4, Section 3, T.14N.-R.3W., Chippewa Twp., Isabella Co., MI.
 N.89°59'47"E. 2655.96' (I-13) SE. corner, Section 34, T.15N.-R.3W., Denver Twp., Isabella Co. MI.
 S.89°54'10"W. 2655.92' (G-13) SE. corner, Section 33, T.15N.-R.3W., Denver Twp., Isabella Co., MI

Signed by _____
 Surveyor's Michigan License No. 21567



Date 12/14/99