

**LAND CORNER RECORDATION CERTIFICATE**  
**Filing Requirement of Act 74, Mich. P.A. 1970**  
**Isabella County Remonumentation**

JAN 25 2000

SECTION

For Corners in  
Isabella

(County)

Located In: Corner Code#:

- |                                       |                            |             |
|---------------------------------------|----------------------------|-------------|
| 1. Public Land Survey                 | T. <u>15N</u> R. <u>3W</u> | <u>J-13</u> |
|                                       | T. _____ R. _____          | _____       |
|                                       | T. _____ R. _____          | _____       |
| 2. Public Controlling in Section      | S. _____ T. _____ R. _____ | _____       |
|                                       | S. _____ T. _____ R. _____ | _____       |
| 3. Miscellaneous Property in Section  | S. _____ T. _____ R. _____ | _____       |
|                                       | S. _____ T. _____ R. _____ | _____       |
| 4. Lot No. _____, Recorded Plat _____ |                            |             |
| 5. Private Claims _____               |                            |             |

199900012556  
 Filed for Record in  
 ISABELLA COUNTY, MI  
 SHARON A BROWN  
 On 12-16-1999 At 08:35:14 am.  
 RE LAND COR 9.00  
 Liber 1 Page 335 - 335

Register of Deeds Stamp & File Number


I, Jan S. Fokens, in a field survey on November 22, 1999, do hereby certify that under requirements of P.A. 74, Michigan P.A. of 1970, the corner points mentioned in lines 1 and 2 above were in conformance with regulations and rules therefore as required in the current manual of survey instructions of the United States Department of the Interior, Bureau of Land Management or by a decree of a Court of Law and/or that the corner points mentioned in lines 3, 4 and 5 above were in conformance with the rules of the Michigan Board of Land Surveyors or by a Decree of a Court of Law, established, re-established, monumented, re-monumented, recovered, found as expressed below.

**NOTE: Not more than 2 corners, all in the same town and range, may be recorded on this certificate.**

1	A	B	C	D	E	F	G	H	I	J	K	L	M
2		6	5		4		3		2		1		
3													
4		7		8		9		10		11		12	
5													
6		18		17		16		15		14		13	
7													
8		19		20		21		22		23		24	
9													
10		30		29		28		27		26		25	
11													
12		31		32		33		34		35		36	
13													

A. Description of original monument and accessories and/or subsequent restoration:

- G.L.O Original Survey:  
 Township: Robert Clark Jr. 2<sup>nd</sup> Quarter 1831  
 Page 2,6 original field notes
- County Survey Records:  
 None of Record
- L.C.R.C.:  
 None of Record
- Surveys of Record:  
 Liber 002, Page 619 October 30, 1975 Clinton Cole Distances and witnesses noted
- Unrecorded Survey:  
 No Isabella County Road Commission notes available

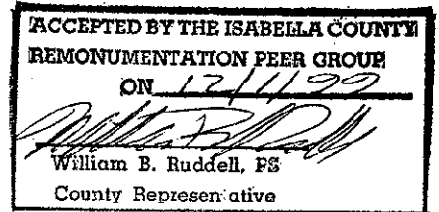

B. Description of corner evidence found and/or method applied in restoring or re-establishing corner:

- This corner established in Isabella County Remonumentation Program. See dossier for detailed report.  
 Corner re-established as an obliterated corner
- Pulled called distance from a LCRC, Liber 3, Page 779 for J-1, 26.35'
  - Excavated to a depth of approximately 2.0'.
  - Found an old 15" culvert which was left in the road and is now abandoned.
  - Set corner at called distance from J-1 according to said survey on line between J-1 and K-1 above abandoned culvert.

Accepted as the best available evidence of the position of the accepted corner and restored with Standard Monument Corner.

C. Description of monument for corner and accessories established to perpetuate locating the position of the corner:

Set Standard Isabella County Monument in Monument Box, stamped J-13 and PS 21567.

- J-13 S. 1/4 Corner, Section 35, T.15N.-R.3W., Denver Township, Isabella County**
- S.58°E. 78.53' Set LSC nail and cap in N. face of service pole
  - N.32°E. 37.63' Top center of cable riser
  - N.60°W. 61.78' Found nail and flagging in E. fade of 30" double Cottonwood tree
  - N.05°E. 57.20' Found nail and cap in E. face of power pole
  - West 26.35' (J-1) N. 1/4 Corner, Section 2, T.14N.-R.3W., Chippewa Township, Isabella County, MI
  - S.89°58'07"E. 2629.91' (K-13) SE. Corner, Section 35, T.15N.-R.3W., Denver Twp. Isabella Co., MI.
  - N89°59'59"W. 2657.60' (I-13) SW. Corner, Section 35, T.15N.-R.3W., Denver Twp., Isabella Co., MI.

Signed by Jan S. Fokens  
 Surveyor's Michigan License No. 21567

Date 12/14/99