

LAND CORNER RECORDATION CERTIFICATE
Filing Requirement of Act 74, Mich. P.A. 1970
Isabella County Remonumentation

JAN 25 2000

For Corners in
Isabella

SECTION

(County)	Located In:	Corner Code#:
1. Public Land Survey	T. <u>15N</u> R. <u>3W</u>	<u>L-13</u>
	T. _____ R. _____	_____
	T. _____ R. _____	_____
2. Public Controlling in Section	S. _____ T. _____ R. _____	_____
	S. _____ T. _____ R. _____	_____
3. Miscellaneous Property in Section	S. _____ T. _____ R. _____	_____
	S. _____ T. _____ R. _____	_____
4. Lot No. _____, Recorded Plat _____		
5. Private Claims _____		

199900012558
 Filed for Record in
 ISABELLA COUNTY, MI
 SHARON A BROWN
 On 12-16-1999 At 08:35:24 am.
 RE LAND COR 9.00
 Liber 1 Page 337 - 337

Register of Deeds Stamp & File Number


I, Jan S. Fokens, in a field survey on November 29, 1999, do hereby certify that under requirements of P.A. 74, Michigan P.A. of 1970, the corner points mentioned in lines 1 and 2 above were in conformance with regulations and rules therefore as required in the current manual of survey instructions of the United States Department of the Interior, Bureau of Land Management or by a decree of a Court of Law and/or that the corner points mentioned in lines 3, 4 and 5 above were in conformance with the rules of the Michigan Board of Land Surveyors or by a Decree of a Court of Law, established, re-established, monumented, re-monumented, recovered, found as expressed below.

1	A	B	C	D	E	F	G	H	I	J	K	L	M
2	6	5	4	3	2	1							
3													
4	7	8	9	10	11	12							
5													
6	18	17	16	15	14	13							
7													
8	19	20	21	22	23	24							
9													
10	30	29	28	27	26	25							
11													
12	31	32	33	34	35	36							
13													

NOTE: Not more than 2 corners, all in the same town and range, may be recorded on this certificate.

A. Description of original monument and accessories and/or subsequent restoration:

- G.L.O Original Survey:
 Township: Robert Clark Jr. 2nd Quarter 1831
 Page 2,6 original field notes
- County Survey Records:
 None of Record
- L.C.R.C.:
 None of Record
- Surveys of Record:
 None of Record
- Unrecorded Survey:
 No Isabella County Road Commission notes available

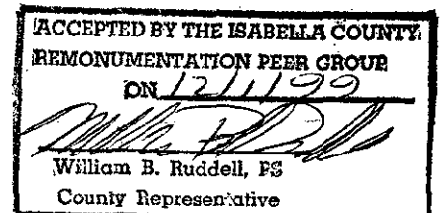

B. Description of corner evidence found and/or method applied in restoring or re-establishing corner:

This corner established in Isabella County Remonumentation Program. See dossier for detailed report.

- No evidence of corner found.
- Set corner equidistant and on line between M-1/M-13 and K-13 according to the original G.L.O.

Accepted as the best available evidence of the position of the original corner and replaced with Standard Monument Corner.

C. Description of monument for corner and accessories established to perpetuate locating the position of the corner:

Set Standard Isabella County Monument in Monument Box, stamped L-13 and PS 21567.

- L-13 S. 1/4 Corner, Section 36, T.15N.-R.3W., Denver Township, Isabella County, MI.**
- S.10°W. 57.35' Set LSC nail and tag in W. face of 3" Poplar tree
 - N.02°E. 7.60' Found nail and cap in S. face of 4" Poplar tree
 - S.72°E. 40.78' Set LSC nail and tag in N. face of 3" Oak tree
 - West 14.83' (L-1) N. 1/4 Corner, Section 1, T.14N.-R.3W., Chippewa Twp., Isabella Co., MI
 - N.89°48'20"E. 2640.80' (M-1/M-13) Common Corner between Denver, Chippewa, Greendale, and Geneva Twps.
 - S.89°48'20"W. 2640.80' (K-13) SW. Corner, Section 35, T.15N.-R.3W., Denver Twp., Isabella Co., MI.

Signed by Jan S. Fokens Date 12/14/99
 Surveyor's Michigan License No. 21567

 FORM APPROVED BY MICHIGAN STATE BOARD OF LAND SURVEYORS, JAN.28, 1971
 REVISED MAY 14, 1975
 REVISED JAN., 1983