

00531

LAND CORNER RECORDATION CERTIFICATE
Filing Requirement of Act 74, Mich. P.A. 1970
Isabella County Remonumentation

SURVEY & REMONUMENTATION

MAR 09 1999

SECTION

For Corners in
Isabella

Table with columns: (County), Located In, Corner Code#. Rows include Public Land Survey, Public Controlling in Section, Miscellaneous Property in Section, Lot No., Private Claims.

9900000531
Filed for Record in
ISABELLA COUNTY, MI
SHARON A BROWN
On 01-19-1999 At 08:15:03 am.
RE LAND COR 9.00
Liber 1 Page 300 - 300

Register of Deeds Stamp & File Number


I, Jan S. Fokens, in a field survey on July 21, 1998, do hereby certify that under requirements of P.A. 74, Michigan P.A. of 1970, the corner points mentioned in lines 1 and 2 above were in conformance with regulations and rules therefore as required in the current manual of survey instructions of the United States Department of the Interior, Bureau of Land Management or by a decree of a Court of Law and/or that the corner points mentioned in lines 3, 4 and 5 above were in conformance with the rules of the Michigan Board of Land Surveyors or by a Decree of a Court of Law, established, re-established, monumented, re-monumented, recovered, found as expressed below.

NOTE: Not more than 2 corners, all in the same town and range, may be recorded on this certificate.

Grid table with columns A-M and rows 1-13. A dot is marked at row 13, column C.

A. Description of original monument and accessories and/or subsequent restoration:

- 1. G.L.O Original Survey
Township Lines: 1st quarter 1837 John Hodgson
Page 214, 216 Original Field Notes
2. County Survey Records:
Liber 1, Page 130-131 1880 J.A. Graham
3. L.C.R.C.
Liber 4, Page 1255 Gerald Gray Recorded date July 20, 1994 Set Bar & Cap
4. Surveys of Record
Liber 5, Page 438 Found rod with cap
5. Unrecorded Survey
None available
No Isabella County Road Commission Notes available

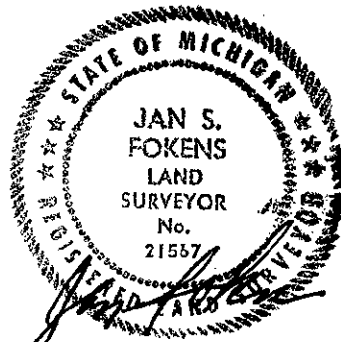

B. Description of corner evidence found and/or method applied in restoring or re-establishing corner:

This corner established in Isabella County Remonumentation Program. See dossier for detailed report.

This is an existent corner


- 1. Found capped iron
2. Excavated to 3 feet. Found no further evidence.

Accepted as the best available evidence of the position of the original corner and replaced with Standard Monument Corner.

C. Description of monument for corner and accessories established to perpetuate locating the position of the corner:

Set Standard Isabella County Monument in Monument Box stamped D-13 and P.S. 21567.

- D-13 S. 1/4 Corner, Section 32, T.15N.-R.4W., Isabella Township, Isabella County.
S.77°W. 55.64' Top center of 4" pipe filled with concrete
S.13°E. 23.29' Set nail & tag in West face of power pole
N.01°E. 77.90' Set nail & tag in East face of power pole
N.17°E. 40.00' Set nail & tag in Southeast face of a corner fence post
N.89°59'43"W 2637.33' SW. Corner, Section 32, T.15N.-R.4W., Isabella Township, Isabella County
N.90°00'00"E 2637.85' SE. Corner, Section 32, T.15N.-R.4W., Isabella Township, Isabella County

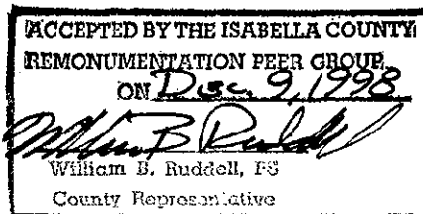

Signed by Jan S. Fokens
Surveyor's Michigan License No. 21567

Date Dec. 30, 1998