

00532

LAND CORNER RECORDATION CERTIFICATE
Filing Requirement of Act 74, Mich. P.A. 1970
Isabella County Remonumentation

SURVEY & REMONUMENTATION

MAR 09 1999

SECTION

For Corners in Isabella

(County) Located In: Corner Code#:
1. Public Land Survey T. 15N R. 4W E-13
2. Public Controlling in Section S. T. R.
3. Miscellaneous Property in Section S. T. R.
4. Lot No. Recorded Plat
5. Private Claims

9900000532
Filed for Record in ISABELLA COUNTY, MI
SHARON A BROWN
On 01-19-1999 At 08:15:06 am.
RE LAND COR 9.00
Liber 1 Page 301 - 301

Register of Deeds Stamp & File Number


I, Jan S. Fokens, in a field survey on November 19, 1998, do hereby certify that under requirements of P.A. 74, Michigan P.A. of 1970, the corner points mentioned in lines 1 and 2 above were in conformance with regulations and rules therefore as required in the current manual of survey instructions of the United States Department of the Interior, Bureau of Land Management or by a decree of a Court of Law and/or that the corner points mentioned in lines 3, 4 and 5 above were in conformance with the rules of the Michigan Board of Land Surveyors or by a Decree of a Court of Law, established, re-established, monumented, re-monumented, recovered, found as expressed below.

Table with 13 rows and 13 columns labeled A-M. Contains numbers 1-36 in a grid pattern.


NOTE: Not more than 2 corners, all in the same town and range, may be recorded on this certificate.

A. Description of original monument and accessories and/or subsequent restoration:

- 1. G.L.O Original Survey Township Lines: 1st quarter 1837 John Hodgson Page 214, 216 Original Field Notes
2. County Survey Records: Liber 1, Page 130-131 1880 J.A. Graham Liber 2, Page 111-112 December 1879 A.K. Herrington
3. L.C.R.C. Liber 1, Page 409 Herbert Fluharty Recorded date January 10, 1977 Found 3/4" iron
4. Surveys of Record: Liber 2, Page 181 What found not listed Liber 2, Page 483 Found 3/4" iron Liber 3, Page 604 What found not listed Liber 5, Page 338 Found 1 1/4" pipe in monument box
5. Unrecorded Survey LSC Field notes distances noted No Isabella County Road Commission Notes Available

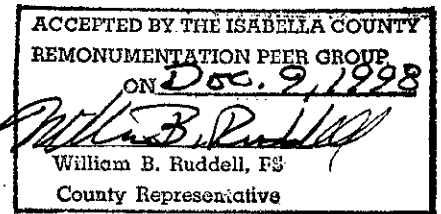

- B. Description of corner evidence found and/or method applied in restoring or re-establishing corner: This corner established in Isabella County Remonumentation Program. See dossier for detailed This is an existent corner
1. Found 2" pipe in monument box
2. Within the 2" pipe was a 3/4" x 3.0' solid rod
3. Excavated to 2.5'. Found no further evidence.

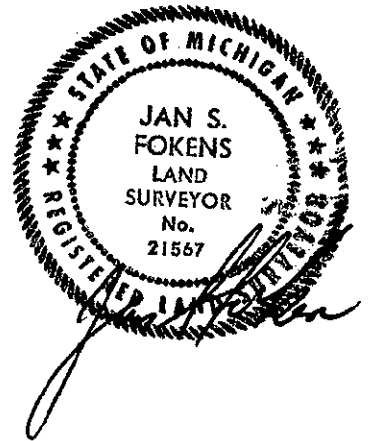

Accepted as the best available evidence of the position of the original corner and replaced with Standard Monument Corner.

C. Description of monument for corner and accessories established to perpetuate locating the position of the corner: Set Standard Isabella County Monument in Monument Box stamped E-13 and P.S. 21567.

E-13 SE. Corner, Section 32, T.15N.-R.4W., Isabella Township, Isabella County
S.05°E. 35.16' Found LSC nail and tag in E. face of power pole
S.52°W. 65.76' Found nail and tag in E. face of power pole
S.48°W. 73.53' E. side of the Stop/Road sign leg
West 60.68' E-1, NE. Corner, Section 5, T.14N.-R.4W., Union Township, Isabella County
West 2637.85' D-13, S. 1/4 Corner, Section 32, T.15N.-R.4W., Isabella Township, Isabella County

Signed by Jan S. Fokens
Surveyor's Michigan License No. 21567

Date OCT. 30, 1998