

MAY 05 1997

116494

COMMISSION

LAND CORNER RECORDATION CERTIFICATE
Filing Requirement of Act 74, Mich. P.A. 1970
Isabella County Remonumentation

For Corners in Isabella

(County)

Located In:

Corner Code#:

- 1. Public Land Survey T. 15 N.R. 4 W. G-2
2. Public Controlling in Section S. T. R.
3. Miscellaneous Property in Section S. T. R.
4. Lot No., Recorded Plat
5. Private Claims

STATE OF MICHIGAN COUNTY OF ISABELLA RECEIVED FOR RECORD

DEC 26 9 21 AM '96

000118 ARON A. REGISTER DEEDS

Register of Deeds Stamp & File Number

I, Jan S. Fokens, in a field survey on Oct., 1996, do hereby state that under requirements of P.A. 74, Michigan P.A. of 1970, the corner points mentioned in lines 1 and 2 above were in conformance with regulations and rules therefore as required in the current manual of survey instructions of the United States Department of the Interior, Bureau of Land Management or by a decree of a Court of Law and/or that the corner points mentioned in lines 3, 4 and 5 above were in conformance with the rules of the Michigan Board of Land Professionals or by a Decree of a Court of Law, established, re-established, monumented, recovered, found as expressed below.

NOTE: Not more than 2 corners, all in the same town and range, may be recorded on this certificate.

Grid table with columns A-M and rows 1-13. Cell (2,4) contains a star symbol.

A. Description of original monument and accessories and/or subsequent restoration:

- 1. Original G.L.O. Survey: Township lines Second Quarter 1837 by John Hodgson Subdivision & Re-survey Fourth Quarter 1837 by Henry Nichalson Page 262 original field notes
2. County Survey Records: Book 2, Page 290 Joseph A. Graham November 1885 Book 2, Page 319 Joseph A. Graham November 19, 1886
3. L.C.R.C.: Liber 1, Page 344 Paul B. Lapham July 9, 1975 Found 1/2" iron
4. Surveys of Record: Liber 2, Page 673 Found capped iron Liber 3, Page 565 Found 1/2" iron with cap Liber 4, Page 26 Found 1/2" iron with cap
5. Unrecorded Surveys: R.E.I. files Found capped iron

ACCEPTED BY THE ISABELLA COUNTY REMONUMENTATION PEER GROUP ON 12/3/96 William B. Ruddell, PS County Representative


B. Description of corner evidence found and/or method applied in restoring or re-establishing corner:

- This corner established in Isabella County Remonumentation Program. See dossier for detailed report.
1. Found 5/8" capped iron 18" long with cap numbers unrecognizable 0.5 feet deep
2. Excavated to depth of 3' No evidence of further material

Accepted as best available evidence of the position of the original corner and replaced with Standard Monument Corner G-2 was approved for remonumentation at a Peer Review Committee meeting on December 3, 1996.

C. Description of monument for corner and accessories established to perpetuate locating the position of the corner:

- Set Standard Isabella County Monument in Monument Box.
N.20°E., 95.70' Found nail and tag in SE. face of White Pine
N.40°E., 42.35' Found nail and tag in SE. face of 18" Ash
S.40°E., 53.43' Found nail and tag in NE. face of 5" Maple
N.75°W., 43.80' Found nail and tag in S. face 5" Elm

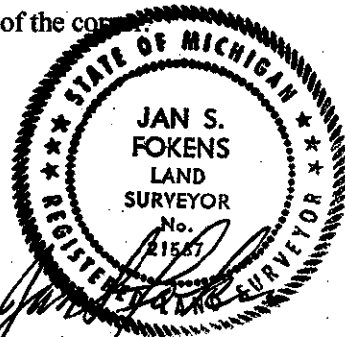

Signed by Jan S. Fokens Surveyor's Michigan License No. 21567

Date Dec 17, 1996