

**SURVEY &
REMONUMENTATION**

MAY 05 1997

COMMISSION

116496

LAND CORNER RECORDATION CERTIFICATE
Filing Requirement of Act 74, Mich. P.A. 1970
Isabella County Remonumentation

For Corners in
Isabella

(County)

	Located In:	Corner Code#:
1. Public Land Survey	T. <u>15 N.</u> R. <u>4 W.</u>	<u>H-2</u>
	T. _____ R. _____	_____
	T. _____ R. _____	_____
2. Public Controlling in Section	S. _____ T. _____ R. _____	_____
	S. _____ T. _____ R. _____	_____
3. Miscellaneous Property in Section	S. _____ T. _____ R. _____	_____
	S. _____ T. _____ R. _____	_____
4. Lot No. _____, Recorded Plat		
5. Private Claims _____		

STATE OF MICHIGAN
COUNTY OF ISABELLA
RECEIVED FOR RECORD

DEC 26 9 23 AM '96
000120

SHARON A. DEWYN
REGISTER OF DEEDS

Register of Deeds Stamp & File Number

I, Jan S. Fokens, in a field survey on Oct., 1996, do hereby state that under requirements of P.A. 74, Michigan P.A. of 1970, the corner points mentioned in lines 1 and 2 above were in conformance with regulations and rules therefore as required in the current manual of survey instructions of the United States Department of the Interior, Bureau of Land Management or by a decree of a Court of Law and/or that the corner points mentioned in lines 3, 4 and 5 above were in conformance with the rules of the Michigan Board of Land Professionals or by a Decree of a Court of Law, established, re-established, monumented, recovered, found as expressed below.

NOTE: Not more than 2 corners, all in the same town and range, may be recorded on this certificate.

	A	B	C	D	E	F	G	H	I	J	K	L	M
2	6	5	4						2	1			
3													
4	7	8	9	10	11	12							
5													
6	18	17	16	15	14	13							
7													
8	19	20	21	22	23	24							
9													
10	30	29	28	27	26	25							
11													
12	31	32	33	34	35	36							
13													

A. Description of original monument and accessories and/or subsequent restoration:

1. Original G.L.O. Survey:
Township lines Second Quarter 1837 by John Hodgson
Subdivision & Re-survey Fourth Quarter 1837 by Henry Nichalson
Corner not set in original survey

2. County Survey Records:

None

3. L.C.R.C.:

None

4. Surveys of Record:


Liber 5, Page 469 Set PK nail and tag in NW. root of 24" Elm

5. Unrecorded Surveys:

LSC notes Section 3 Subdivision Plot

B. Description of corner evidence found and/or method applied in restoring or re-establishing corner:
This corner established in Isabella County Remonumentation Program. See dossier for detailed report.

1. Found PK nail and tag in NW. root of 24" Elm

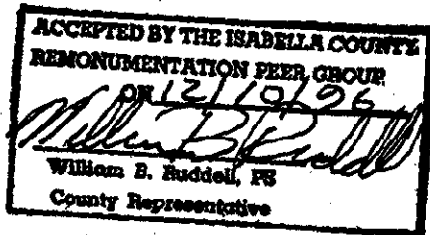


Corner set at intersection of straight lines run from established opposite Quarter Section Corners. Corner H-2 was approved for remonumentation at a Peer Review Committee meeting on December 10, 1996.

C. Description of monument for corner and accessories established to perpetuate locating the position of the corner:
PK nail and LSC tag in NW. root of 24" Elm.

No permanent accessories available as witness points.

See dossier for section breakdown with bearing and distances to opposite quarter corners.

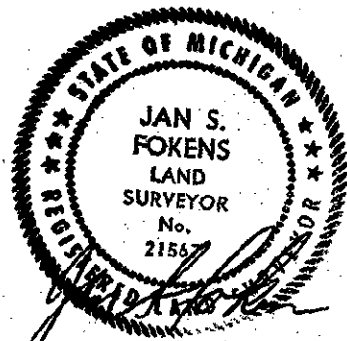

Signed by Jan S. Fokens
Surveyor's Michigan License No. 21567

Date Dec. 17, 1996