

**SURVEY &
REMONUMENTATION**

MAY 05 1997

COMMISSION

116499

**LAND CORNER RECORDATION CERTIFICATE
Filing Requirement of Act 74, Mich. P.A. 1970
Isabella County Remonumentation**

For Corners in
Isabella
(County)

	Located In:	Corner Code#:
1. Public Land Survey	T. <u>15 N.R. 4 W.</u>	<u>I-2</u>
	T. _____ R. _____	_____
2. Public Controlling in Section	S. _____ T. _____ R. _____	_____
	S. _____ T. _____ R. _____	_____
3. Miscellaneous Property in Section	S. _____ T. _____ R. _____	_____
	S. _____ T. _____ R. _____	_____
4. Lot No. _____, Recorded Plat		_____
5. Private Claims		_____

STATE OF MICHIGAN
COUNTY OF ISABELLA
RECEIVED FOR RECORD

Dec 26 9 22 AM '96
000123
SHARON A. BROWN
REGISTER OF DEEDS

Register of Deeds Stamp & File Number

I, Jan S. Fokens, in a field survey on Nov., 1996, do hereby state that under requirements of P.A. 74, Michigan P.A. of 1970, the corner points mentioned in lines 1 and 2 above were in conformance with regulations and rules therefore as required in the current manual of survey instructions of the United States Department of the Interior, Bureau of Land Management or by a decree of a Court of Law and/or that the corner points mentioned in lines 3, 4 and 5 above were in conformance with the rules of the Michigan Board of Land Professionals or by a Decree of a Court of Law, established, re-established, monumented, recovered, found as expressed below.

NOTE: Not more than 2 corners, all in the same town and range, may be recorded on this certificate.

1	A	B	C	D	E	F	G	H	I	J	K	L	M
2	6	5	4	3	2	1							
3													
4	7	8	9	10	11	12							
5													
6	18	17	16	15	14	13							
7													
8	19	20	21	22	23	24							
9													
10	30	29	28	27	26	25							
11													
12	31	32	33	34	35	36							
13													

A. Description of original monument and accessories and/or subsequent restoration:

- Original G.L.O. Survey:
Township lines Second Quarter 1837 by John Hodgson
Subdivision & Re-survey Fourth Quarter 1837 by Henry Nicholson
Page 252 original field notes
- County Survey Records:
Small Book 1, Pages 52 and 53 Dated July 13, 1901 Edwin R. Coburn
- L.C.R.C.:
Liber 1, Page 370 Herbert L. Fluharty May 4, 1976
Liber 1, Page 409 Herbert L. Fluharty January 10, 1977
- Surveys of Record:
None
- Unrecorded Surveys:
MDOT R.O.W. map
Mears notes

ACCEPTED BY THE ISABELLA COUNTY
REMONUMENTATION PEER GROUP
ON 12/10/96
William B. Ruddell
William B. Ruddell, PS
County Representative

Found hex bolt Field verified witnesses
Found 5/8" iron Field verified witnesses


B. Description of corner evidence found and/or method applied in restoring or re-establishing corner:
This corner established in Isabella County Remonumentation Program. See dossier for detailed report.

- Found PK nail at road surface 8.5' E. of centerline of Mission
- Excavated 0.3' to concrete surface.
- No further excavation completed.

Accepted as best available evidence of the position of the original corner and replaced with Standard Monument Corner I-2 was approved for remonumentation at a Peer Review Committee meeting on December 10, 1996.

C. Description of monument for corner and accessories established to perpetuate locating the position of the corner:

- Set Standard Isabella County Monument in Monument Box.
- N.40°E. 60.25' Found nail and LSC disk in N. face of 8" Maple
 - S.88°E. 43.50' Found nail and LSC tag in S. face of power pole
 - S.22°E. 66.94' Found nail and LSC tag in N. face of 2' Maple
 - S.46°W. 73.55' Found nail and LSC tag in S. face of power pole

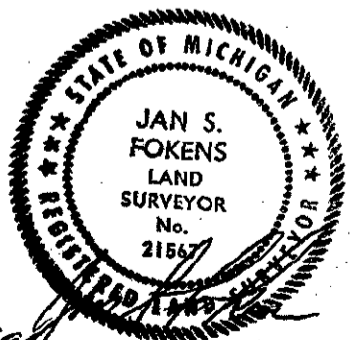

Signed by *Jan S. Fokens*
Surveyor's Michigan License No. 21567

Date Dec. 17, 1996