

LAND CORNER RECORDATION CERTIFICATE
Filing Requirement of Act 74, Mich. P.A. 1970
 Isabella County Remonumentation

JAN 25 2000

SECTION _____

For corners in

ISABELLA
(County)

Located In:
 VERNON TOWNSHIP

Corner Code # _____

199900012176
 Filed for Record in
 ISABELLA COUNTY, MI
 SHARON A BROWN
 On 12-07-1999 At 09:50:34 am.
 RE LAND COR 9.00
 Liber 1 Page 311 - 311

- | | | |
|---|--------------------------|-------|
| 1. Public Land Survey
N 1/4 CORNER
SECTION 33 | T <u>16N</u> R <u>4W</u> | F-11 |
| | T _____ R _____ | _____ |
| | T _____ R _____ | _____ |
| | T _____ R _____ | _____ |
| 2. Property Controlling
in Section | S _____ T _____ R _____ | _____ |
| | S _____ T _____ R _____ | _____ |
| 3. Miscellaneous
Property in Sec. | S _____ T _____ R _____ | _____ |
| | S _____ T _____ R _____ | _____ |
4. Lot No. _____, Recorded Plat _____
5. Private Claims _____

Register of Deeds Stamp & File Number


	A	B	C	D	E	F	G	H	I	J	K	L	M
2	6	5	4	3	2	1							
3													
4	7	8	9	10	11	12							
5													
6	18	17	16	15	14	13							
7													
8	19	20	21	22	23	24							
9													
10	30	29	28	27	26	25							
11													
12	31	32	33	34	35	36							
13													

I, Timothy E Bebee, in a field survey on November 10, 1999, do hereby state that under requirements of P.A. 74, Michigan P.A. of 1970, the corner points mentioned in lines 1 and 2 above were in conformance with regulations and rules therefore as required in the current manual of survey instructions of the United States Department of the Interior, Bureau of Land Management or by a decree of a Court of Law and/or that the corner points mentioned in lines 3, 4 and 5 above were in conformance with the rules of the Michigan Board of Land Surveyors or by a Decree of a Court of Law; established, re-established, monumented, recovered, found as expressed below:

NOTE: Not more than 2 corners, all in the same town and range, may be recorded on this certificate.

A. Description of original monument and accessories and/or subsequent restoration:

- 1837 H. Nicholson GLO.....Set Post
- 1882 J. Graham CS.....Set Ironwood Stake 4x4
- 1997 T. Bebee, Unrecorded Survey.....Set Capped Iron #39074
- 1998 T. Bebee, Unrecorded Survey.....Found Capped Iron #39074

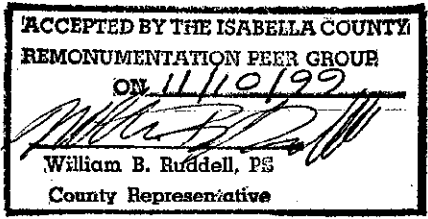

B. Description of corner evidence found and/or method applied in restoring or reestablishing corner:

Set 1/2" Rod with P.S. Cap #39074 in remains of old fence line to North and South, approximately 3' North of the centerline of an old road grade. Set on line between the Northwest and the Northeast section corners at the doubled distance from the Northeast corner to the East 1/8 line fence to the North. Excavated area and found no evidence and no metallic readings. Accepted corner as the best available evidence of the perpetuated corner.

C. Description of monument for corner and accessories established to perpetuate locating the position of the corner:

A Remonumentation monument stamped #39074 was set at the position of the Corner and is accepted as the best available evidence of the perpetuated corner

Witnesses:

- S 45° E 12.55' Nail and Tag in West face of corner fence post
- S 30° W 22.00' Nail and Tag in West face 5" oak
- S 65° W 23.00' Nail and tag in North face of a cut off Power Pole
- N 20° W 7.30' Nail and tag in East face of 8" oak



Signed by Timothy E Bebee Date 11/10/99
 Surveyor's Michigan License No. 39074