

JAN 25 2000

LAND CORNER RECORDATION CERTIFICATE
Filing Requirement of Act 74, Mich. P.A. 1970
Isabella County Remonumentation

SECTION

For corners in

ISABELLA
(County)

Located In:
VERNON TOWNSHIP

Corner Code # 199900012179

Filed for Record in
ISABELLA COUNTY, MI
SHARON A BROWN
On 12-07-1999 At 09:50:44 am.
RE LAND COR 9.00
Liber 1 Page 314 - 314

- 1. Public Land Survey NE CORNER SECTION 33 T 16N R 4W G-11
2. Property Controlling in Section S T R
3. Miscellaneous Property in Sec. S T R

Register of Deeds Stamp & File Number

- 4. Lot No. , Recorded Plat
5. Private Claims


I, Timothy E. Bebee, in a field survey on November 10, 1999, do hereby state that under requirements of P.A. 74, Michigan P.A. of 1970, the corner points mentioned in lines 1 and 2 above were in conformance with regulations and rules therefore as required in the current manual of survey instructions of the United States Department of the Interior, Bureau of Land Management or by a decree of a Court of Law and/or that the corner points mentioned in lines 3, 4 and 5 above were in conformance with the rules of the Michigan Board of Land Surveyors or by a Decree of a Court of Law; established, re-established, monumented, recovered, found as expressed below:

Grid table with columns A-M and rows 2-13. A dot is marked at the intersection of column G and row 11.

NOTE: Not more than 2 corners, all in the same town and range, may be recorded on this certificate.

A. Description of original monument and accessories and/or subsequent restoration:

- 1837 H. Nicholson GLO.....Set Post
1882 J. Graham CS.....Found old Bearing down and decayed

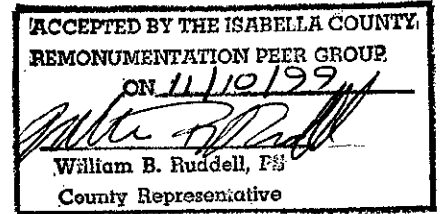

B. Description of corner evidence found and/or method applied in restoring or reestablishing corner:


Found well point 3'± East of centerline North-South gravel road 1.5'± North of fence line West and 8'± South of fence line East. Excavated below iron found no other evidence and no metallic readings. Accepted Corner as the best available evidence of the perpetuated corner.

C. Description of monument for corner and accessories established to perpetuate locating the position of the corner:

A Remonumentation monument stamped #39074, placed inside a monument box, was set at the position of the Corner and is accepted as the best available evidence of the perpetuated corner

Witnesses:

- N 66° E 46.88' Found Nail in 8" maple
S 54° E 34.02' Nail and Tag in 6" aspen
S 41° W 43.20' Nail and Tag in 4" aspen
N 80° W 74.59' Nail and tag in 28" willow

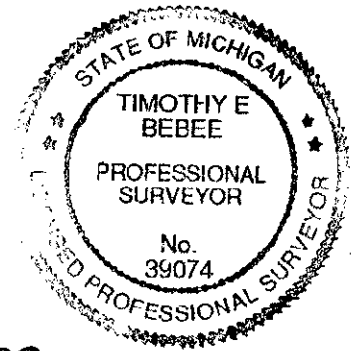

Signed by Timothy E. Bebee
Surveyor's Michigan License No. 39074

Date 11/10/99