

LAND CORNER RECORDATION CERTIFICATE
Filing Requirement of Act 74, Mich. P.A. 1970
 Isabella County Remonumation

JAN 25 2000

For corners in

ISABELLA
 (County)

Located In:
 VERNON TOWNSHIP

Corner Copied for Record in
 199900012180
 ISABELLA COUNTY, MI
 SHARON A BROWN
 On 12-07-1999 At 09:50:48 am.
 RE LAND COR 9.00
 Liber 1 Page 315 - 315

SECTION

- | | | |
|-------------------------|------------|------|
| 1. Public Land Survey | T 16N R 4W | G-12 |
| E 1/4 CORNER | T R | |
| SECTION 33 | T R | |
| | T R | |
| 2. Property Controlling | S T R | |
| in Section | S T R | |
| 3. Miscellaneous | S T R | |
| Property in Sec. | S T R | |

Register of Deeds Stamp & File Number

4. Lot No. _____, Recorded Plat _____
 5. Private Claims _____


A	B	C	D	E	F	G	H	I	J	K	L	M
2	6	5	4	3	2	1						
3												
4	7	8	9	10	11	12						
5												
6	18	17	16	15	14	13						
7												
8	19	20	21	22	23	24						
9												
10	30	29	28	27	26	25						
11												
12	31	32	33	34	35	36						
13												

I, Timothy E Bebee, in a field survey on November 10, 19 99, do hereby state that under requirements of P.A. 74, Michigan P.A. of 1970, the corner points mentioned in lines 1 and 2 above were in conformance with regulations and rules therefore as required in the current manual of survey instructions of the United States Department of the Interior, Bureau of Land Management or by a decree of a Court of Law and/or that the corner points mentioned in lines 3, 4 and 5 above were in conformance with the rules of the Michigan Board of Land Surveyors or by a Decree of a Court of Law; established, re-established, monumented, recovered, found as expressed below:

NOTE: Not more than 2 corners, all in the same town and range, may be recorded on this certificate.

A. Description of original monument and accessories and/or subsequent restoration:

- 1837 H. Nicholson GLO.....Set Post
- 1882 J. Graham CS.....Set Well Point
- 1996 M. Robison, Unrecorded Survey.....Found 1 1/2" pipe
- 1997 T. Bebee, Unrecorded Survey.....Found 1 1/2" O. D. Pipe

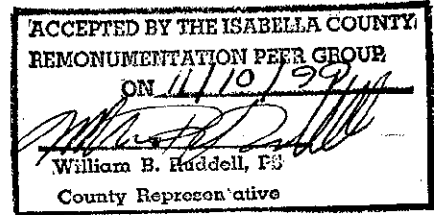

B. Description of corner evidence found and/or method applied in restoring or reestablishing corner:


Found 1 1/2" O. D. pipe in centerline of gravel road North-South @ fence line West. Excavated below found no other evidence and no metallic readings. Accepted as the best evidence of the perpetuated corner.

C. Description of monument for corner and accessories established to perpetuate locating the position of the corner:

A Remonumentation monument stamped #39074, placed inside a monument box, was set at the position of the Corner and is accepted as the best available evidence of the perpetuated corner

Witnesses:

- N 30° E 63.97' Found Nail and tag in fence post
- S 89° W 28.21' Found J.S.F. Nail and Tag in fence corner post
- N 64° W 37.71' Found Nail and Tag in fence post
- N 31° W 74.59' Found Nail and tag in 5" elm

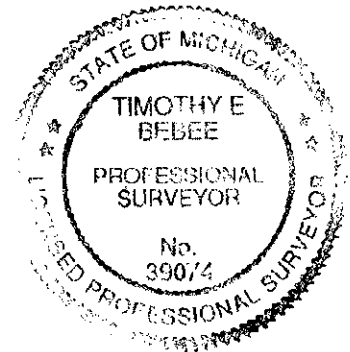

Signed by Timothy E Bebee

Date 11/10/99

Surveyor's Michigan License No. 39074