

LAND CORNER RECORDATION CERTIFICATE
Filing Requirement of Act 74, Mich. P.A. 1970
 Isabella County Remonumentation

JAN 25 2000

For corners in

ISABELLA
 (County)

Located In:
 VERNON TOWNSHIP

Corner Code #

SECTION

1. Public Land Survey
 SE CORNER
 SECTION 33

T 16N R 4W
 T ___ R ___
 T ___ R ___
 T ___ R ___
 S ___ T ___ R ___
 S ___ T ___ R ___
 S ___ T ___ R ___
 S ___ T ___ R ___

G-13

199900012181
 Filed for Record in
 ISABELLA COUNTY, MI
 SHARON A BROWN
 On 12-07-1999 At 09:50:53 am.
 RE LAND COR 9.00
 Liber 1 Page 316 - 316

Register of Deeds Stamp & File Number

4. Lot No. _____, Recorded Plat _____
 5. Private Claims _____


A	B	C	D	E	F	G	H	I	J	K	L	M
2	6	5	4	3	2	1						
3												
4	7	8	9	10	11	12						
5												
6	18	17	16	15	14	13						
7												
8	19	20	21	22	23	24						
9												
10	30	29	28	27	26	25						
11												
12	31	32	33	34	35	36						
13												

I, Timothy E Bebee, in a field survey on November 10, 19 99, do hereby state that under requirements of P.A. 74, Michigan P.A. of 1970, the corner points mentioned in lines 1 and 2 above were in conformance with regulations and rules therefore as required in the current manual of survey instructions of the United States Department of the Interior, Bureau of Land Management or by a decree of a Court of Law and/or that the corner points mentioned in lines 3, 4 and 5 above were in conformance with the rules of the Michigan Board of Land Surveyors or by a Decree of a Court of Law; established, re-established, monumented, recovered, found as expressed below:

NOTE: Not more than 2 corners, all in the same town and range, may be recorded on this certificate.

A. Description of original monument and accessories and/or subsequent restoration:

- 1837 J. Hodgson GLO.....Set Post
- 1882 J. Graham CS.....Set Red Oak Stake and small stones around
- 1977 J. Jones, PA 132.....Mon. box (L.002, p.420)
- 1979 H. Fluharty, PA 132.....SE cor. Sec. 33 (L.003, P.420)
- 1981 H. Fluharty, PA 132.....SE cor. Sec. 33 (L.003, P.565)
- 1982 H. Fluharty, PA 132.....SE cor. Sec. 33 (L.004, P.26)
- 1991 J. Fokens, PA 132.....Found Iron in Mon. Box(L.005, P.173)
- 1991 J. Fokens, LCRC, 1131.....Found Iron in Mon. Box
- 1996 M. Robison, Unrecorded Survey.....Found 1/2" Iron in Mon. Box
- 1997 T. Bebee, Unrecorded Survey.....Found Iron in Mon. Box

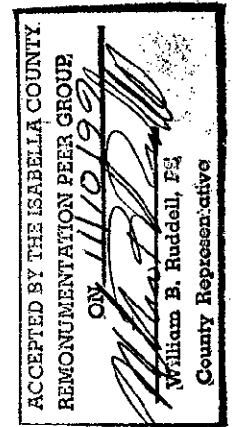

B. Description of corner evidence found and/or method applied in restoring or reestablishing corner:

Found 1/2" Iron Monument Box 1.6' North of centerline of Vernon road East-West 1.5' West of centerline of Crawford road North 29.5' West of centerline Crawford road South. 31.50 West of found 1/2" Iron in Mon. Box the corner common to sections 3 & 4 T15N-R4W. Excavated below found no other evidence. Accepted corner as the best available evidence of the perpetuated corner.

C. Description of monument for corner and accessories established to perpetuate locating the position of the corner:

A Remonumentation monument stamped #39074, placed inside a monument box, was set at the position of the Corner and is accepted as the best available evidence of the perpetuated corner

Witnesses:

- N 74° E 115.69' Found Nail and Tag #21567 in Utility pole. Multiple other wit's in pole.
- S 66° W 103.82' Set Nail and Tag in 8" maple
- N 32° W 98.21' Set Nail and Tag in 16" apple
- N 25° W 58.57' Found Nail and tag no # in stub pole. Multiple other wit's in pole.

Signed by Timothy E Bebee
 Surveyor's Michigan License No. 39074

Date 11/10/1999

