

**SURVEY &
REMONUMENTATION**

MAY 05 1997

116597


COMMISSION

ISABELLA COUNTY REMONUMENTATION

LAND CORNER RECORDATION CERTIFICATE
Filing Requirement of Act 74, Mich. P.A. 1970

For corners in

<u>ISABELLA</u> (County)	Located In:	Corner Code #
1. Public Land Survey	T <u>16N</u> R <u>4W</u>	<u>H - 1</u>
	T _____ R _____	_____
	T _____ R _____	_____
	T _____ R _____	_____
2. Property Controlling in Section	S _____ T _____ R _____	_____
	S _____ T _____ R _____	_____
3. Miscellaneous Property in Sec.	S _____ T _____ R _____	_____
	S _____ T _____ R _____	_____

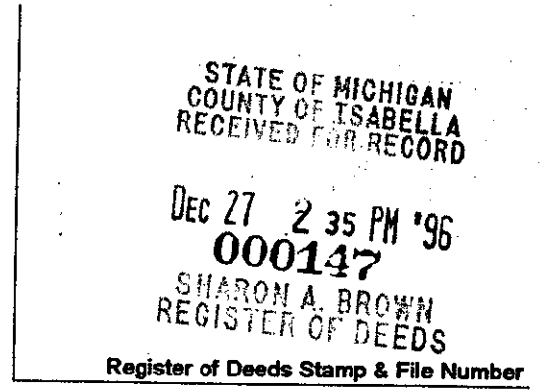

4. Lot No. _____, Recorded Plat _____
5. Private Claims _____

I, MARK R. ROBISON, in a field survey on July 10, 1996 do hereby state that under requirements of P.A. 74, Michigan P.A. of 1970, the corner points mentioned in lines 1 and 2 above were in conformance with regulations and rules therefore as required in the current manual of survey instructions of the United States Department of the Interior, Bureau of Land Management or by a decree of a Court of Law and /or that the corner points mentioned in lines 3, 4 and 5 above were in conformance with the rules of the Michigan Board of Land Surveyors or by a Decree of a Court of Law; established, re-established, monumented, recovered, found as expressed below:

NOTE: Not more than 2 corners, all in the same town and range, may be recorded on this certificate.


A	B	C	D	E	F	G	H	I	J	K	L	M
1												
2	6		5		4		3		2		1	
3												
4	7		8		9		10		11		12	
5												
6	18		17		16		15		14		13	
7												
8	19		20		21		22		23		24	
9												
10	30		29		28		27		26		25	
11												
12	31		32		33		34		35		36	
13												

A. Description of original monument and accessories and/or subsequent restoration:

- | | |
|---------------------------------|--------------------------------------|
| 1837 NOT SET IN GLO | WIT.-SAME AS 1973 LCRC |
| 1883 GRAHAM (CSR 2-235) | 1976 FLUHARTY-LCRC |
| FOUND 1/4 POST | FD 1/2" BAR REPLACED WITH 5/8" X 18" |
| WIT.-PINE STUMP 24" N3 1/2E 41L | REROD WITH RLS CAP |
| TAM STUMP 14" S69W 36 1/2L | WEST 10.75 S1/4 COR SEC 34 |
| 1973 SEDGMAN-LCRC | WIT.-SAME AS 1973 LCRC |
| 1/2" BAR MIDWAY ON LINE (SPM) | |
| WIT.-N40W 39.80 T.P. | |
| N70E 98.70 P.P. | |
| S75E 94.87 P.P. | |
| 1973 SEDGMAN (132) SURVEY | |

B. Description of corner evidence found and/or method applied in restoring or reestablishing corner:

FOUND 5/8" X 18" REROD. MEAS. WEST 2627.22 (PREVIOUS SURVEY 2627.17) TO G-1. PREVIOUS SURVEY MEAS 2627.16 EAST TO I-3. FOUND TWO 1973 WITNESSES.

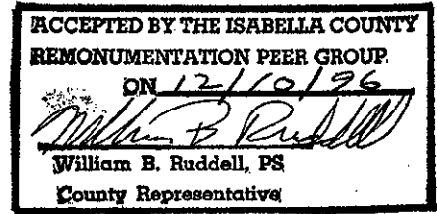

SEE DOSSIER FOR DETAILED REPORT.

C. Description of monument for corner and accessories established to perpetuate locating the position of the corner:

H-1: N 1/4 CORNER OF SECTION 3
SET 5/8" X 24" ALUMINUM ROD WITH ISABELLA COUNTY REMONUMENTATION CAP. ACCEPTED AS BEST AVAILABLE EVIDENCE OF ACCEPTED POSITION OF CORNER.

- WITNESSES:
N68E 98.70 N&T IN P.P. (OBT)
N28E 32.08 N&T IN 14" ELM
S78E 94.87 N&T IN P.P. (OBT)
N48W 43.08 N&T IN 15" ELM

Signed by Mark R. Robison
Surveyor's Michigan License No. 27458

Date 12-23-96

