

MAR 09 1998

ISABELLA COUNTY REMONUMENTATION

SECTION

LAND CORNER RECORDATION CERTIFICATE

Filing Requirement of Act 74, Mich. P.A. 1979 or Record in

For corners in

ISABELLA (County)

Located in:

Corner Code #

- 1. Public Land Survey T16N R4W I-3
2. Property Controlling in Section S T R
3. Miscellaneous Property in Sec. S T R


9700126892 Filed for Record in ISABELLA COUNTY, MI SHARON A BROWN On 12-23-1997 At 03:00:30 pm. RE LAND COR 9.00 Book OR Vol. 1 Pg. 209 - 209

Register of Deeds Stamp & File Number

- 4. Lot No. Recorded Plat
5. Private Claims

I, MARK R. ROBISON, in a field survey on July 1, 1997 do hereby state that under requirements of P.A. 74, Michigan P.A. of 1970, the corner points mentioned in lines 1 and 2 above were in conformance with regulations and rules therefore as required in the current manual of survey instructions of the United States Department of the Interior, Bureau of Land Management or by a decree of a Court of Law and for that the corner points mentioned in lines 3, 4 and 5 above were in conformance with the rules of the Michigan Board of Land Surveyors or by a Decree of a Court of Law; established, re-established, monumented, recovered, found as expressed below.

NOTE: Not more than 2 corners, all in the same town and range, may be recorded on this certificate.

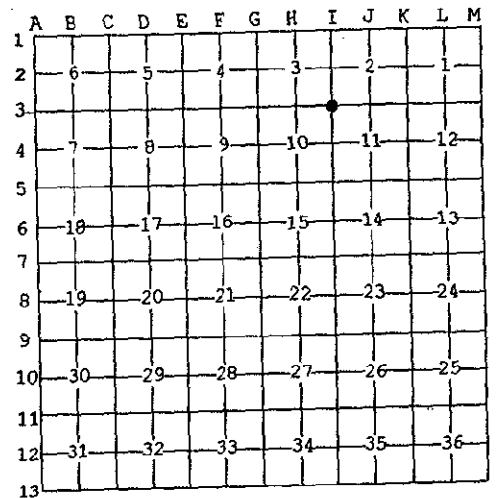

A. Description of original monument and accessories and/or subsequent restoration:


- 1837 Hodgson Set Post
Wit-Hemlk 12" S19E 27L & Hemlk 9" N9W 8L
1850 Burt
Set Post in re-survey 79.96 ch N of I-5
Wit-Hemlk 22 S32W 25 & Hemlk 18 N8E 23
1879 Herrington CSR 2-84
W. Oak Stake, Stone beside 14x14x6 marked "E" on side and "X" on top
Wit-Oak stake S45W 71 & Oak stake N45W 71
1879 Herrington CSR 2-94-Same as above
1879 Herrington CSR 2-96-Same as above
May 1958 MSHD-Fd 1/4" iron pin in Mon Box
Wit-N55W 51.49 P.P. & N50E 59.32 T.P.
S60E 61.01 Cor F. Post
1972 Courtright LCRC-Fd 3/8" rod Mon Box
Wit-none
1972 Courtright (132)survey-Mon Box Hwy
1973 Sedgman (132)survey
Fd 3/8" rod in Mon Box
1973 Lapham (132)survey-Ref. 1972 LCRC
1976 Fluharty LCRC-Fd 1/2" Iron Mon Box
Wit-N53E 59.60 T.P. & N60W 51.50 P.P.

- S58E 61.05 Cor. F. Post
1977 Jones (132) survey-Fd rod Mon box
Wit-NW 51.5, N&T, P.P.
NE 59.57, N&T, T.P.
SE 60.94 nail in Cor. F. Post
1978 Lapham(132)survey Fd 3/8"rod Mon Box
1981 Lapham PBLA Files-Fd 3/8"rod Mon Box
1981 Lapham PBLA Files-Fd 3/8"rod Mon Box
Undated Co. Rd. Comm Files-Iron Mon Box
Wit-N50E 59.32 T.P. & N55W 51.49 P.P.
S60E 61.01 Co. Fe. Post

B. Description of corner evidence found and/or method applied in restoring or reestablishing corner:

Found 3/8" x 40" iron rod in 3/4" x 24" pipe in monument box. Found 1976 and County Road Commission witnesses as noted below. Measured North 2647.40 (prev. survey 2647.89) to I-2. Measured West in previous survey 2641.80 to H-3.

See dossier for detailed report.

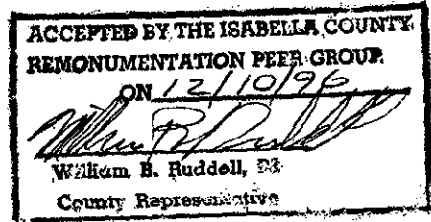

C. Description of monument for corner and accessories established to perpetuate locating the position of the corner:

Set 5/8" x 24" Aluminum Rod with Isabella County Remonumentation Cap in Monument Box. Accepted as best available evidence of the accepted position of the corner.

- Witnesses:
N53E 56.00', nail & tag, New T.P. (Prev. 59.60)
N60W 54.00', nail & tag, New T.P. (Prev. 51.50)
S58E 61.05', nail & tag, Cor. F. Post (OBT)
S20W 171.57', nail & tag, P.P.



Signed by [Signature]
Surveyor's Michigan License No. 27458

Date 11-04-97