

01902

SURVEY & REMONUMENTATION

LAND CORNER RECORDATION CERTIFICATE

Filing Requirement of Act 74, Mich. P.A. 1970

MAR 09 1998

For Corners in Isabella (County)

2800001902 Filed for Record in ISABELLA COUNTY, MI SHARON A BROWN On 02-27-1998 At 03:37:45 pm. RE LAND COR 9.00 Book OR Vol. 1 Pg. 224 - 224

SECTION

- 1. Public Land Survey T. 16N. R. 5W. A-1 T. 16N. R. 6W. M-1 T. 17N R. 5W A-13 Clare Co. 2. Public Controlling in Section S. T. R. M-13 Clare Co. 3. Miscellaneous Property in Section S. T. R. 4. Lot No. Recorded Plat 5. Private Claims

Register of Deeds Stamp & File Number


I, Mark Robison, in a field survey on October 2, 1997, do hereby certify that under requirements of P.A. 74, Michigan P.A. of 1970, the corner points mentioned in lines 1 and 2 above were in conformance with regulations and rules therefore as required in the current manual of survey instructions of the United States Department of the Interior, Bureau of Land Management or by a decree of a Court of Law and/or that the corner points mentioned in lines 3, 4 and 5 above were in conformance with the rules of the Michigan Board of Land Surveyors or by a Decree of a Court of Law, established, re-established, monumented, re-monumented, recovered, found as expressed below.

Grid table with columns A-M and rows 1-13. Row 1: A-1, B, C, D, E, F, G, H, I, J, K, L, M. Row 2: 6, 5, 4, 3, 2, 1. Row 3: 7, 8, 9, 10, 11, 12. Row 4: 18, 17, 16, 15, 14, 13. Row 5: 19, 20, 21, 22, 23, 24. Row 6: 30, 29, 28, 27, 26, 25. Row 7: 31, 32, 33, 34, 35, 36.

NOTE: Not more than 2 corners, all in the same town and range, may be recorded on this certificate.

A. Description of original monument and accessories and/or subsequent restoration:

- 1. Original G.L.O. Survey: Township Lines: 2nd Quarter by John Hodgson, 1837 Subdivision & Re-survey: 4th Quarter by Henry Nicholson, 1837 Page 502 & 508 Original Field Notes Subsequent Survey: 2nd Quarter by William A. Burt Page 572 & 594 Original Field Notes 2. County Survey of Records: None Found 3. L.C.R.C. None Found 4. Surveys of Record: None Found 5. Unrecorded Surveys: Paul B. Lapham & Associates, Certificate of Survey Found 1 1/4" pipe Witnesses Noted Mark Robison, Certificate of Survey Found Sucker Rod

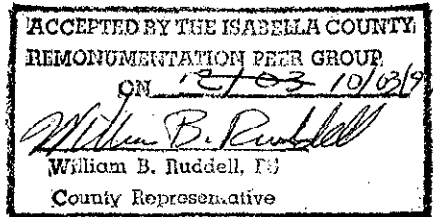

B. Description of corner evidence found and/or method applied in restoring or re-establishing corner:

This corner established in Isabella County Remonumentation Program. See dossier for detailed report. - Found 5/8" x 36" iron in broken clay tile and all 1996 witnesses and two 1997 witnesses. The 1 1/4" pipe had been removed and had been partially re-driven in the ground about three feet from the corner. We accepted the 1/2" iron in the clay tile.

Accepted as best available evidence of the position of the original corner and replaced with Standard Monument.

C. Description of monument for corner and accessories established to perpetuate locating the position of the corner:

- Set Standard Isabella County Monument in a Monument Box marked PS 27458. N40°E 3.60' Nail & Tag in 12" Cedar N60°W 119.80' Nail & Tag in 5" Cedar S52°W 17.41' Nail & Tag in 5" Cedar S40°E 65.5' Nail & Tag in 7" Cedar

Signed by Mark Robison Surveyor's Michigan License No. 27458

Date 2-26-98

