

LAND CORNER RECORDATION CERTIFICATE
Filing Requirement of Act 74, Mich. P.A. 1970
Isabella County Remonumentation

00113

000216

For Corners in
Isabella

(County)	Located In:	Corner Code#:
1. Public Land Survey	T. <u>16N.</u> R. <u>5W.</u>	<u>A-5</u>
	T. _____ R. _____	_____
	T. _____ R. _____	_____
2. Public Controlling in Section	S. _____ T. _____ R. _____	_____
	S. _____ T. _____ R. _____	_____
3. Miscellaneous Property in Section	S. _____ T. _____ R. _____	_____
	S. _____ T. _____ R. _____	_____
4. Lot No. _____, Recorded Plat _____		
5. Private Claims _____		

9800000143
 Filed for Record in
 ISABELLA COUNTY, MI
 SHARON A BROWN
 On 01-06-1998 At 11:21:12 am.
 RE LAND COR 9.00
 Book OR Vol. 1 Pg. 216 - 216

Register of Deeds Stamp & File Number


I, Mark Robison, in a field survey on July, 1997, do hereby certify that under requirements of P.A. 74, Michigan P.A. of 1970, the corner points mentioned in lines 1 and 2 above were in conformance with regulations and rules therefore as required in the current manual of survey instructions of the United States Department of the Interior, Bureau of Land Management or by a decree of a Court of Law and/or that the corner points mentioned in lines 3, 4 and 5 above were in conformance with the rules of the Michigan Board of Land Surveyors or by a Decree of a Court of Law, established, re-established, monumented, re-monumented, recovered, found as expressed below.

NOTE: Not more than 2 corners, all in the same town and range, may be recorded on this certificate.

1	A	B	C	D	E	F	G	H	I	J	K	L	M
2	6	5	4	3	2	1							
3													
4	7	8	9	10	11	12							
5													
6	18	17	16	15	14	13							
7													
8	19	20	21	22	23	24							
9													
10	30	29	28	27	26	25							
11													
12	31	32	33	34	35	36							
13													

A. Description of original monument and accessories and/or subsequent restoration:

- G.L.O Original Survey
 Township Lines: 2nd Quarter 1837 John Hodgson
 Subdivision: 4th Quarter 1837 H. Nicholson
 Page 506 Original Field Notes
- County Survey Records:
 Liber 3, Page 90, October 11, 1897, Trussell
- L.C.R.C.
 None
- Surveys of Record
 Liber 1, Page 261, January 14, 1971, Nowak, Land Division
- Unrecorded Survey
 None

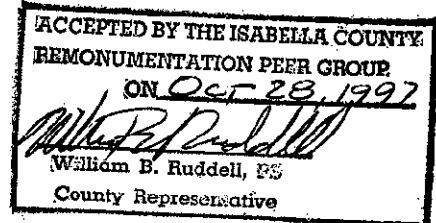

B. Description of corner evidence found and/or method applied in restoring or re-establishing corner:

This corner established in Isabella County Remonumentation Program. See dossier for detailed report.
 Found 1/2" iron at SW. corner of Lot 66 per Nowak survey. Purports to be (A-5) corner common to Section 7 and 18 on town line.

Found pointed stone marked X and old buggy axel (lying down) at corner per C.S.R. notes.
 Found 30" pine stump (notched) N.54°E., 60.1' (C.S.R. N.54.5°E., 60.55') and remains of pine stump N.38°W., 69.9' (C.S.R. N.35.5°W., 69.3').
 Found fence corner S.52°W., 52.7' with fence South, North, and West (appears to be West Right of Way fence).
 Section corner per Nowak survey is N.45°W., 56.4'. Nowak states he found an iron pipe.

C. Description of monument for corner and accessories established to perpetuate locating the position of the corner:
 Set Standard Isabella County Monument.

- S.70°W. 7.95' Nail & tag in 7" Maple
- S.28°E. 18.10' Nail & tag in 6" Maple
- East 29.75' Nail & tag in 12" Oak
- N.22°E. 16.10' Nail & tag in 4" Oak

SURVEY &
 REMONUMENTATION

MAR 09 1998

SECTION



Signed by Mark R. Robison
 Surveyor's Michigan License No. 27458

Date 12-30-97